


1 LOCATION OF WATER WELL: Fraction NE 1/4 SW 1/4 NW 1/4 Section Number 4 Township Number 13S Range Number 20W
 County: Douglas

Distance and direction from nearest town or city street address of well if located within city?

1608 N 1400 rd Lawrence, Ks

2 WATER WELL OWNER: FE Kansas Remediation trust
 RR#, St. Address, Box #: 1608 N 1400 rd
 City, State ZIP Code: Lawrence, Ks 66046
Global Positioning Systems (decimal degrees, min. of 4 digits)
 Latitude: 38.947356039
 Longitude: -95.184531429
 Elevation: 813
 Datum: _____
 Data Collection Method: _____

3 MARK WELL'S LOCATION WITH AN "X" IN SECTION BOX:

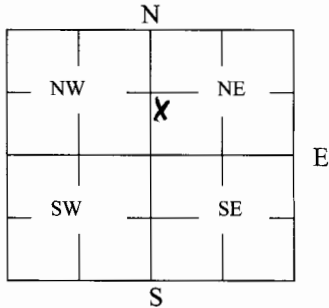

4 DEPTH OF WELL 62'3" ft. PSW 06B
WELL'S STATIC WATER LEVEL 34' ft

WELL WAS USED AS:

- 1 Domestic
- 2 Irrigation
- 3 Feedlot
- 4 Industrial
- 5 Public Water Supply
- 6 Oil Field Water Supply
- 7 Domestic (Lawn & Garden)
- 8 Air Conditioning
- 9 Dewatering
- 10 Monitoring
- 11 Injection Well
- 12 Other _____

Was a chemical/bacteriological sample submitted to Department? Yes _____ No

5 TYPE OF BLANK CASING USED:
 1 Steel 3 RMP (SR) 5 Wrought 7 Fiberglass 9 Other (Specify below)
 2 PVC 4 ABS 6 Asbestos-Cement 8 Concrete Tile

Blank casing diameter 5 in. Was casing pulled? Yes _____ No If yes, how much _____
 Casing height above or below land surface 38" in.

6 GROUT PLUG MATERIAL: 1 Neat cement 2 Cement grout 3 Bentonite 4 Other _____

Grout Plug Intervals: From 59' ft. to 2" ft., From _____ ft. to _____ ft., From _____ to _____ ft.

What is the nearest source of possible contamination:

- 1 Septic tank
 - 2 Sewer lines
 - 3 Watertight sewer lines
 - 4 Lateral lines
 - 5 Cess pool
 - 6 Seepage pit
 - 7 Pit privy
 - 8 Sewage lagoon
 - 9 Feedyard
 - 10 Livestock pens
 - 11 Fuel Storage
 - 12 Fertilizer storage
 - 13 Insecticide storage
 - 14 Abandoned water well
 - 15 Oil well/Gas well
 - 16 Other (specify below) _____
- Direction from well? _____
 How many feet? _____

FROM	TO	PLUGGING MATERIALS	FROM	TO	PLUGGING MATERIALS
<u>59'</u>	<u>2"</u>	<u>Bentonite</u>			
<u>2</u>	<u>0</u>	<u>Soil</u>			

7 CONTRACTOR'S OR LANDOWNER'S CERTIFICATION: This water well was plugged under my jurisdiction and was completed on (mo/day/year) 1-25-07 and this record is true to the best of my knowledge and belief. Kansas Water Well Contractor's License No. 704. This Water Well Record was completed on (mo/day/year) 1-25-07 under the business name of MAXS by (signature) David Humpal

INSTRUCTIONS: Use typewriter or ballpoint pen. Please press firmly and print clearly. Please fill in blanks, underline or circle the correct answers. Send top three copies to Kansas Department of Health and Environment, Bureau of Water, Geology Section, 1000 SW Jackson St., Ste. 420, Topeka, Kansas 66612-1367. Telephone: 785/296-5522. Send one to Water Well Owner and retain one for your records. Visit us at <http://www.kdheks.gov/geo/waterwells>.