


1 LOCATION OF WATER WELL: County: <u>DOUGLAS</u>	Fraction <u>NW 1/4 SW 1/4 SW 1/4</u>	Section Number <u>17</u>	Township Number <u>13</u>	Range Number <u>20</u> <span style="border: 1px solid black; border-radius: 50%; padding: 2px;">E/W</span>
---	--------------------------------------	--------------------------	---------------------------	--

Distance and direction from nearest town or city street address of well if located within city?  
0.6 mile South of Lawrence on Bissard

2 WATER WELL OWNER: <u>KDOT</u> RR#, St. Address, Box #: <u>1462 U.S. Highway 40</u> City, State ZIP Code: <u>Lawrence, KS 66044</u>	Global Positioning Systems (decimal degrees, min. of 4 digits) Latitude: _____ Longitude: _____ Elevation: _____ Datum: _____ Data Collection Method: _____
--	--

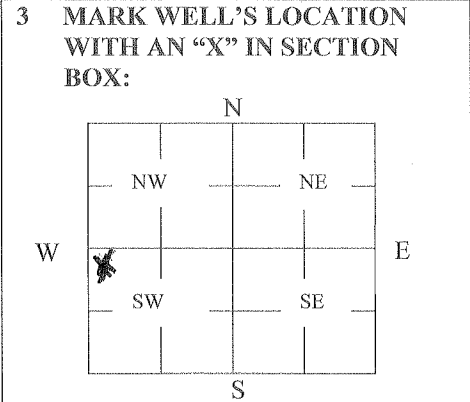

4 DEPTH OF WELL 72' ft.  
 WELL'S STATIC WATER LEVEL 21' ft.  
 WELL WAS USED AS:  
 Domestic      5 Public Water Supply      9 Dewatering  
 2 Irrigation      6 Oil Field Water Supply      10 Monitoring  
 3 Feedlot      7 Domestic (Lawn & Garden)      11 Injection Well  
 4 Industrial      8 Air Conditioning      12 Other \_\_\_\_\_  
 Was a chemical/bacteriological sample submitted to Department? Yes \_\_\_\_\_ No

5 TYPE OF BLANK CASING USED:  
 Steel      3 RMP (SR)      5 Wrought      7 Fiberglass      9 Other (Specify below) \_\_\_\_\_  
 2 PVC      4 ABS      6 Asbestos-Cement      8 Concrete Tile \_\_\_\_\_  
 Blank casing diameter 6" in. Was casing pulled? Yes \_\_\_\_\_ No  If yes, how much \_\_\_\_\_  
 Casing height ~~above~~ or below land surface 10 ft.

6 GROUT PLUG MATERIAL:      1 Neat cement      2 Cement grout       Bentonite      4 Other \_\_\_\_\_  
 Grout Plug Intervals: From 72' ft. to 10' ft., From \_\_\_\_\_ ft. to \_\_\_\_\_ ft., From \_\_\_\_\_ to \_\_\_\_\_ ft.  
 What is the nearest source of possible contamination:  
 1 Septic tank      6 Seepage pit      11 Fuel Storage      16 Other (specify below) Highway  
 2 Sewer lines      7 Pit privy      12 Fertilizer storage  
 3 Watertight sewer lines      8 Sewage lagoon      13 Insecticide storage  
 4 Lateral lines      9 Feedyard      14 Abandoned water well      Direction from well? South  
 5 Cess pool      10 Livestock pens      15 Oil well/Gas well      How many feet? 10 ft

FROM	TO	PLUGGING MATERIALS	FROM	TO	PLUGGING MATERIALS
<u>72</u>	<u>10</u>	<u>Bentonite ball plug</u>			
<u>10</u>	<u>0</u>	<u>TOP Soil</u>			

7 CONTRACTOR'S OR LANDOWNER'S CERTIFICATION: This water well was plugged under my jurisdiction and was completed on (mo/day/year) 9-30-14 and this record is true to the best of my knowledge and belief. Kansas Water Well Contractor's License No. 536. This Water Well Record was completed on (mo/day/year) 10-6-14 under the business name of Hatcher Pump & Well Drilling Inc. by (signature) Tom E. Katcher

INSTRUCTIONS: Use typewriter or ballpoint pen. Please press firmly and print clearly. Please fill in blanks, underline or circle the correct answers. Send top three copies to Kansas Department of Health and Environment, Bureau of Water, Geology Section, 1000 SW Jackson St., Ste. 420, Topeka, Kansas 66612-1367. Telephone: 785/296-5522. Send one to Water Well Owner and retain one for your records. Visit us at <http://www.kdheks.gov/geo/waterwells>.