


1 LOCATION OF WATER WELL: Fraction NE 1/4 NW 4 NW 4 Section Number 15 Township Number 13 Range Number 20 EW
 County: Douglas

Distance and direction from nearest town or city street address of well if located within city?
1.5 miles EAST OF LAWRENCE City Limits

2 WATER WELL OWNER: KDOT Global Positioning Systems (decimal degrees, min. of 4 digits)
 RR#, St. Address, Box #: 1462 US Highway 40 Latitude: _____
 City, State ZIP Code: LAWRENCE, KS 66044 Longitude: _____
 Elevation: _____
 Datum: _____
 Data Collection Method: _____

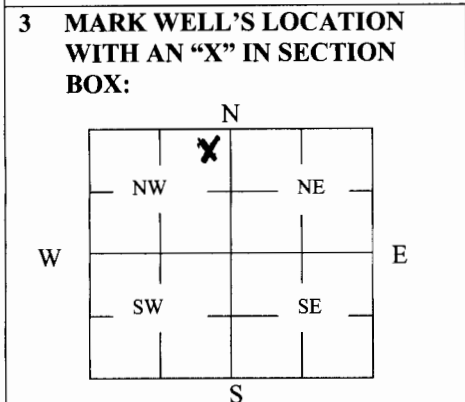

4 DEPTH OF WELL 39' ft.
 WELL'S STATIC WATER LEVEL 31 ft.
 WELL WAS USED AS:
 Domestic 5 Public Water Supply 9 Dewatering
 2 Irrigation 6 Oil Field Water Supply 10 Monitoring
 3 Feedlot 7 Domestic (Lawn & Garden) 11 Injection Well
 4 Industrial 8 Air Conditioning 12 Other _____
 Was a chemical/bacteriological sample submitted to Department? Yes _____ No X

5 TYPE OF BLANK CASING USED:
 1 Steel 3 RMP (SR) 5 Wrought 7 Fiberglass 9 Other (Specify below)
 2 PVC 4 ABS 6 Asbestos-Cement 8 Concrete Tile Rock lined HAND dug
 Blank casing diameter 4 1/2 in. Was casing pulled? Yes _____ No X If yes, how much _____
 Casing height ~~above~~ or below land surface 8 ft in.

6 GROUT PLUG MATERIAL: 1 Neat cement 2 Cement grout Bentonite 4 Other _____
 Grout Plug Intervals: From 39 ft. to 29 ft., From _____ ft. to _____ ft., From _____ to _____ ft.
 What is the nearest source of possible contamination:
 1 Septic tank 6 Seepage pit 11 Fuel Storage 16 Other (specify below) Highway
 2 Sewer lines 7 Pit privy 12 Fertilizer storage
 3 Watertight sewer lines 8 Sewage lagoon 13 Insecticide storage
 4 Lateral lines 9 Feedyard 14 Abandoned water well Direction from well? EAST
 5 Cess pool 10 Livestock pens 15 Oil well/Gas well How many feet? 50 FT

FROM	TO	PLUGGING MATERIALS	FROM	TO	PLUGGING MATERIALS
<u>39</u>	<u>29</u>	<u>Bentonite Hole plug</u>			
<u>29</u>	<u>8</u>	<u>Rock lining From Well</u>			
<u>8</u>	<u>0</u>	<u>TOP Soil</u>			

7 CONTRACTOR'S OR LANDOWNER'S CERTIFICATION: This water well was plugged under my jurisdiction and was completed on (mo/day/year) 10-17-14 and this record is true to the best of my knowledge and belief. Kansas Water Well Contractor's License No. 536. This Water Well Record was completed on (mo/day/year) 10-23-14 under the business name of Patcher Pump & Well Drilling, Inc by (signature) Tom E. Patcher

INSTRUCTIONS: Use typewriter or ballpoint pen. Please press firmly and print clearly. Please fill in blanks, underline or circle the correct answers. Send top three copies to Kansas Department of Health and Environment, Bureau of Water, Geology Section, 1000 SW Jackson St., Ste. 420, Topeka, Kansas 66612-1367. Telephone: 785/296-5522. Send one to Water Well Owner and retain one for your records. Visit us at <http://www.kdheks.gov/geo/waterwells>.