


WATER WELL PLUGGING RECORD Form WWC-5P KSA 82a-1212 ID NO. []

1 LOCATION OF WATER WELL: County: Douglas Fraction NW 1/4 NW 1/4 NW 1/4 Section Number 4 Township Number 13 Range Number 20 EW

Distance and direction from nearest town or city street address of well if located within city? Farmland site: North end

2 WATER WELL OWNER: City of Lawrence RR#, St. Address, Box #: P.O. Box 708 City, State ZIP Code: Lawrence, Ks. Attn: Aiken Rodgers Global Positioning Systems (decimal degrees, min. of 4 digits) Latitude: 38 57 16.6 Longitude: 95 11 46.1 Elevation: Datum: Data Collection Method: Garmin Etrex

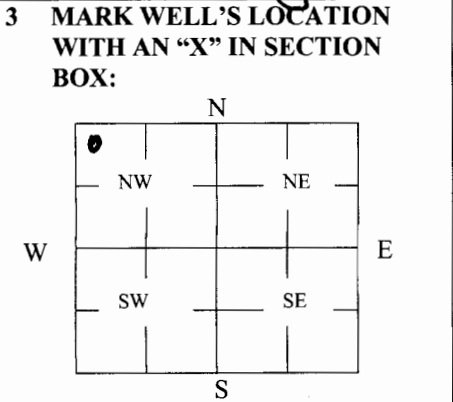

4 DEPTH OF WELL 54' ft. WELL'S STATIC WATER LEVEL 33.54 ft. WELL WAS USED AS: 1 Domestic 2 Irrigation 3 Feedlot 4 Industrial 5 Public Water Supply 6 Oil Field Water Supply 7 Domestic (Lawn & Garden) 8 Air Conditioning 9 Dewatering 10 Monitoring 11 Injection Well 12 Other Was a chemical/bacteriological sample submitted to Department? Yes No

5 TYPE OF BLANK CASING USED: 1 Steel 2 PVC 3 RMP (SR) 4 ABS 5 Wrought 6 Asbestos-Cement 7 Fiberglass 8 Concrete Tile 9 Other (Specify below) Blank casing diameter 8" in. Was casing pulled? Yes No If yes, how much 3 ft Casing height above or below land surface 3' in.

6 GROUT PLUG MATERIAL: 1 Neat cement 2 Cement grout 3 Bentonite 4 Other Clay Grout Plug Intervals: From 54' ft. to 3' ft., From 3' ft. to 0' ft., From to ft. What is the nearest source of possible contamination: 1 Septic tank 2 Sewer lines 3 Watertight sewer lines 4 Lateral lines 5 Cess pool 6 Seepage pit 7 Pit privy 8 Sewage lagoon 9 Feedyard 10 Livestock pens 11 Fuel Storage 12 Fertilizer storage 13 Insecticide storage 14 Abandoned water well 15 Oil well/Gas well 16 Other (specify below) Drainage Ponds Direction from well? South How many feet? 150'

Table with columns: FROM, TO, PLUGGING MATERIALS. Handwritten entries: Top 3' will be removed by City, Bentonite from 54'-3', Clay from 3'-0'

7 CONTRACTOR'S OR LANDOWNER'S CERTIFICATION: This water well was plugged under my jurisdiction and was completed on (mo/day/year) 2/6/15 and this record is true to the best of my knowledge and belief. Kansas Water Well Contractor's License No. 732 This Water Well Record was completed on (mo/day/year) 2/7/15 under the business name of QB Environmental by (signature) James Becker

INSTRUCTIONS: Use typewriter or ballpoint pen. Please press firmly and print clearly. Please fill in blanks, underline or circle the correct answers. Send top three copies to Kansas Department of Health and Environment, Bureau of Water, Geology Section, 1000 SW Jackson St., Ste. 420, Topeka, Kansas 66612-1367. Telephone: 785/296-5522. Send one to Water Well Owner and retain one for your records. Visit us at http://www.kdheks.gov/geo/waterwells.