

WATER WELL RECORD

Form WWC-5

CPHWIS


Division of Water Resources App. No.

1 LOCATION OF WATER WELL: County: Douglas, Fraction 1/4 SW 1/4 NW 1/4 SW 1/4, Section Number 4, Township No. T 13 S, Range Number R 20 E W

Street/Rural Address of Well Location; if unknown, distance & direction from nearest town or intersection: Former Farmland Plant, Contact: Allen Rodgers

Global Positioning System (GPS) information: Latitude: 38.570740, Longitude: 95.115218, Elevation: 877.20 Tol

2 WATER WELL OWNER: City of Lawrence, RR#, Street Address, Box #: P.O. Box 708, City, State, ZIP Code: 6th + Main Lawrence, Ks.

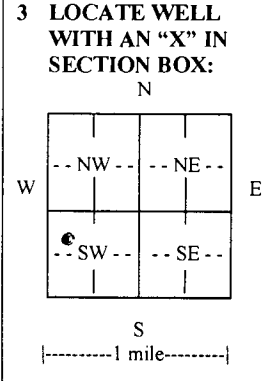

4 DEPTH OF COMPLETED WELL 28', Depth(s) Groundwater Encountered 1) 17', 2) 17', 3) 17', WELL'S STATIC WATER LEVEL 8.78', Pump test data: Well water was 7 1/2' after 28' hours pumping 3/21/14 gpm

5 TYPE OF CASING USED: Steel, PVC, Other, CASING JOINTS: Glued, Clamped, Welded, Threaded, Casing diameter 2.375 in. to 1.8 in.

TYPE OF SCREEN OR PERFORATION MATERIAL: Steel, Stainless Steel, PVC, Brass, Galvanized Steel, None used, SCREEN OR PERFORATION OPENINGS ARE: Continuous slot, Mill slot, Gauze wrapped, Torch cut, Drilled holes, Louvered shutter, Key punched, Wire wrapped, Saw cut, Other (specify)

6 GROUT MATERIAL: Neat cement, Cement grout, Bentonite, Other Concrete, Grout Intervals: From 1.6 ft. to 2 ft., From 2 ft. to 0 ft., What is the nearest source of possible contamination: Septic tank, Lateral lines, Pit privy, Livestock pens, Insecticide storage, Sewer lines, Cesspool, Sewage lagoon, Fuel storage, Abandoned water well, Watertight sewer lines, Seepage pit, Feedyard, Fertilizer storage, Oil well/gas well

Table with columns: FROM, TO, LITHOLOGIC LOG, FROM, TO, LITHO. LOG (cont.) or PLUGGING INTERVALS. Rows include: 0-2 DK Br clay, 2-6 Red Br silty silt, 6-11 Pale yellowish gray sandstone, 11-22 Iron oxide stained silty sandstone, 22-24 yellow-brown sandy shale, 24-28 clay sandy shale.

7 CONTRACTOR'S OR LANDOWNER'S CERTIFICATION: This water well was constructed, reconstructed, or plugged under my jurisdiction and was completed on (mo/day/year) 3/17/14 and this record is true to the best of my knowledge and belief. Kansas Water Well Contractor's License No. 132. This Water Well Record was completed on (mo/day/year) 3/31/14 under the business name of G.B. Environmental by (signature) James Baker

INSTRUCTIONS: Use typewriter or ball point pen. PLEASE PRESS FIRMLY and PRINT clearly. Please fill in blanks and check the correct answers. Send one copy to Kansas Department of Health and Environment, Bureau of Water, Geology Section, 1000 SW Jackson St., Suite 420, Topeka, Kansas 66612-1367. Telephone 785-296-5524. Send one copy to WATER WELL OWNER and retain one for your records. Include fee of \$5.00 for each constructed well. Visit us at http://www.kdheks.gov/waterwell/index.html