

WATER WELL RECORD

Form WWC-5


Division of Water Resources App. No.

Empty box for application number

1 LOCATION OF WATER WELL: County: Douglas, Fraction NW 1/4 NE 1/4 NE 1/4, Section Number 30, Township No. T 13 S, Range Number R 20 E

Street/Rural Address of Well Location; if unknown, distance & direction from nearest town or intersection: If at owner's address, check here [X]. Global Positioning System (GPS) information: Latitude, Longitude, Elevation, Datum, Collection Method

2 WATER WELL OWNER: Mary Lee Robbins, RR#, Street Address, Box #: 1449 N1100 Rd, City, State, ZIP Code: Lawrence, KS 66046

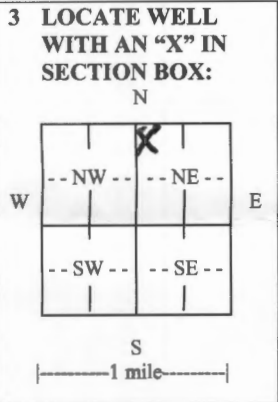


4 DEPTH OF COMPLETED WELL: 152 ft. Depth(s) Groundwater Encountered (1) 9.4 ft. (2) ... (3) ... WELL'S STATIC WATER LEVEL: 9.4 ft. below land surface measured on mo/day/yr. Pump test data: Well water was ... EST. YIELD: ... Bore Hole Diameter ... WELL WATER TO BE USED AS: [X] Domestic, [] Feedlot, [] Oil field water supply, [] Dewatering, [] Other (Specify below)

5 TYPE OF CASING USED: [] Steel, [X] PVC, [] Other STEEL CASING IN WELL. CASING JOINTS: [] Glued, [] Clamped, [] Welded, [] Threaded. Casing diameter: 6 in. to ... Casing height above land surface: 18 in., Weight ... lbs./ft., Wall thickness or gauge No. SDR-24

TYPE OF SCREEN OR PERFORATION MATERIAL: [] Steel, [] Stainless Steel, [] PVC, [] Other (Specify) ... SCREEN OR PERFORATION OPENINGS ARE: [] Continuous slot, [] Mill slot, [] Gauze wrapped, [] Torch cut, [] Drilled holes, [] None (open hole) ... SCREEN-PERFORATED INTERVALS: From ... ft. to ... ft. GRAVEL PACK INTERVALS: From ... ft. to ... ft.

6 GROUT MATERIAL: [] Neat cement, [] Cement grout, [X] Bentonite, [] Other ... Grout Intervals: From 7 ft. to 3 ft., From ... ft. to ... ft. What is the nearest source of possible contamination: [X] Lateral lines, [] Pit privy, [] Livestock pens, [] Insecticide storage, [] Other (specify below)

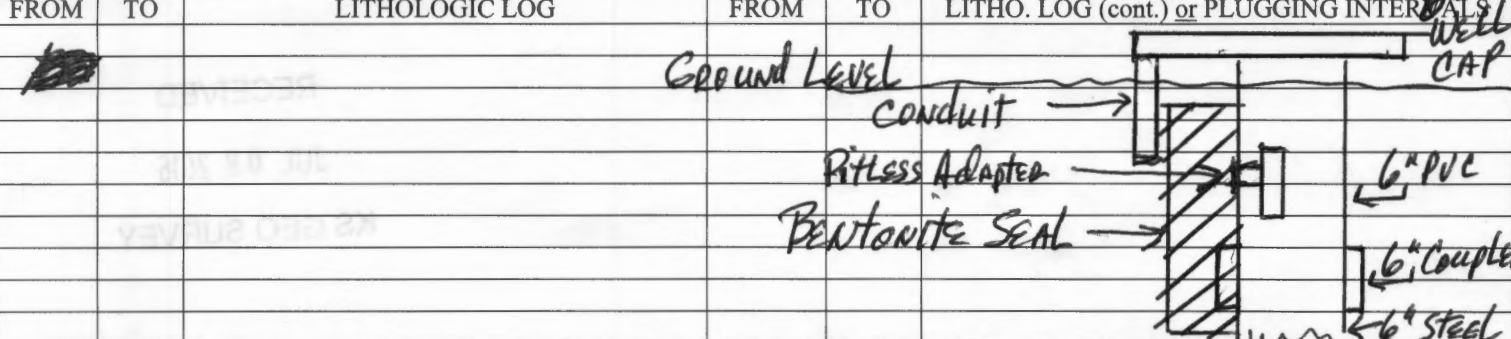

7 CONTRACTOR'S OR LANDOWNER'S CERTIFICATION: This water well was [] constructed, [X] reconstructed, or [] plugged under my jurisdiction and was completed on (mo/day/year) 5-19-16 and this record is true to the best of my knowledge and belief. Kansas Water Well Contractor's License No. 536. This Water Well Record was completed on (mo/day/year) 5-20-16 under the business name of Patches Pump & Well Drilling, Inc. by (signature) Tom Ketchum

INSTRUCTIONS: Use typewriter or ball point pen. PLEASE PRESS FIRMLY and PRINT clearly. Please fill in blanks and check the correct answers. Send three copies (white, blue, pink) to Kansas Department of Health and Environment, Bureau of Water, Geology Section, 1000 SW Jackson St., Suite 420, Topeka, Kansas 66612-1367. Telephone 785-296-5524. Send one copy to WATER WELL OWNER and retain one for your records. Include fee of \$5.00 for each constructed well. Visit us at http://www.kdheks.gov/waterwell/index.html.