

MW-3R

WATER WELL PLUGGING RECORD Form WWC-5P


KSA 82a-1212

ID NO.

1 LOCATION OF WATER WELL: Fraction N 2 1/4 SW 1/4 SW 1/4 1/4 Section Number 4 Township Number T 13 S Range Number 20  E  W  
 County: DOUGLAS

Street/Rural Address of Well Location; if unknown, distance & direction from nearest town or intersection: If at owner's address, check here  Intersections at 2200 Bk of O'Connell & Venture Park Drive  
 Global Positioning Systems (GPS) information:  
 Latitude: 38.947169 (in decimal degrees)  
 Longitude: 95.202483 (in decimal degrees)  
 Elevation: 866.91  
 Horizontal Datum:  WGS84,  NAD83,  NAD27  
 Collection Method:

2 WATER WELL OWNER: City of Lawrence  
 RR#, St. Address, Box #: PO Box 708  
 City, State ZIP Code: Lawrence, KS 66044  
 GPS unit (Make/Model): Cell phone  
 Digital Map/Photo,  Topographic Map,  Land Survey  
 Est. Accuracy:  <3 m,  3-5 m,  5-15 m,  >15 m

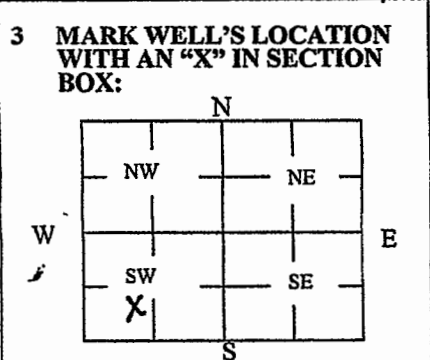

4 DEPTH OF WELL 25.38 ft.  
 WELL'S STATIC WATER LEVEL 10.5 ft.  
 WELL WAS USED AS:  
 Domestic  Public Water Supply  Dewatering  
 Irrigation  Oil Field Water Supply  Monitoring  
 Feedlot  Domestic (Lawn & Garden)  Injection Well  
 Industrial  Air Conditioning  Other  
 Was a chemical/bacteriological sample submitted to Department? Yes  No

5 TYPE OF BLANK CASING USED:  
 Steel  RMP (SR)  Wrought  Fiberglass  Other (Specify below)  
 PVC  ABS  Asbestos-Cement  Concrete Tile  
 Blank casing diameter 2 in. Was casing pulled? Yes  No  If yes, how much \_\_\_\_\_  
 Casing height above or below land surface 3 FT in.

6 GROUT PLUG MATERIAL:  Neat cement  Cement grout  Bentonite  Other \_\_\_\_\_  
 Grout Plug Intervals: From 25.38 ft. to 3 ft., From \_\_\_\_\_ ft. to \_\_\_\_\_ ft., From \_\_\_\_\_ ft. to \_\_\_\_\_ ft.

What is the nearest source of possible contamination:  
 Septic tank  Seepage pit  Fuel storage  Other (specify below)  
 Sewer lines  Pit privy  Fertilizer storage ROADS  
 Watertight sewer lines  Sewage lagoon  Insecticide storage  
 Lateral lines  Feedyard  Abandoned water well  
 Cess pool  Livestock pens  Oil well/Gas well  
 Direction from well? East & North  
 How many feet? 554' - 573'

554 ft EAST of O'Connell RD & 573' North of Venture Park Drive

FROM	TO	PLUGGING MATERIALS	FROM	TO	PLUGGING MATERIALS
<u>25.38</u>	<u>3</u>	<u>Bentonite hole plug</u>			
<u>3</u>	<u>0</u>	<u>TOP SOIL</u>			

7 CONTRACTOR'S OR LANDOWNER'S CERTIFICATION: This water well was plugged under my jurisdiction and was completed on (mo/day/year) 11-12-2021, and this record is true to the best of my knowledge and belief. Kansas Water Well Contractor's License No. 536. This Water Well Record was completed on (mo/day/year) 12-1-2021 under the business name of Patchen Pump & Well Drilling, Inc. by (signature) Sam E. Patchen

Send one white copy to Kansas Department of Health & Environment, Geology Section, 1000 SW Jackson Street, Ste. 420, Topeka, KS 66612-1367. Send one copy to WATER WELL OWNER and retain one for your records.  
 Visit us at <http://www.kdheks.gov/waterwell/index.html> Telephone 785-296-5524.