

MW 6-K

WATER WELL PLUGGING RECORD Form WWC-5P KSA 82a-1212 ID NO. []


1 LOCATION OF WATER WELL: Fraction SE 1/4 SW 1/4 SW 1/4 Section Number 4 Township Number T 13 S Range Number 20 E W

Street/Rural Address of Well Location; if unknown, distance & direction from nearest town or intersection: If at owner's address, check here Intersection at 2200 BLK of O'Connell & Venture Park Drive

Global Positioning Systems (GPS) information: Latitude: 38.947493 (in decimal degrees) Longitude: 95.201881 (in decimal degrees) Elevation: 859.25 Horizontal Datum: WGS84, NAD83, NAD27 Collection Method:

2 WATER WELL OWNER: City of Lawrence RR#, St. Address, Box #: PO Box 708 City, State ZIP Code: Lawrence, KS 66044

GPS unit (Make/Model: Cell phone) Digital Map/Photo, Topographic Map, Land Survey Est. Accuracy: < 3 m, 3-5 m, 5-15 m, > 15 m

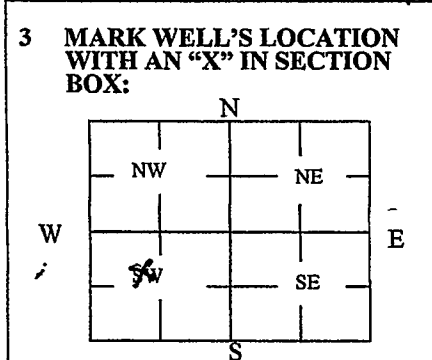

4 DEPTH OF WELL 25.57 ft. WELL'S STATIC WATER LEVEL 8'6" ft. WELL WAS USED AS: Domestic Irrigation Feedlot Industrial Public Water Supply Oil Field Water Supply Domestic (Lawn & Garden) Air Conditioning Dewatering Monitoring Injection Well Other _____ Was a chemical/bacteriological sample submitted to Department? Yes No

5 TYPE OF BLANK CASING USED: Steel PVC RMP (SR) ABS Wrought Asbestos-Cement Fiberglass Concrete Tile Other (Specify below) _____ Blank casing diameter 2" in. Was casing pulled? Yes No If yes, how much _____ Casing height ~~above~~ or below land surface 3 FT ~~in~~.

6 GROUT PLUG MATERIAL: Neat cement Cement grout Bentonite Other _____ Grout Plug Intervals: From 25.5' ft. to 3 ft., From _____ ft. to _____ ft., From _____ ft. to _____ ft. What is the nearest source of possible contamination: Septic tank Sewer lines Watertight sewer lines Lateral lines Cess pool Seepage pit Pit privy Sewage lagoon Feedyard Livestock pens Fuel storage Fertilizer storage Insecticide storage Abandoned water well Oil well/Gas well Other (specify below) Roads Direction from well? EAST & North How many feet? 660 684

660' East of O'Connell Rd & 684' North of Venture Park Drive

FROM	TO	PLUGGING MATERIALS	FROM	TO	PLUGGING MATERIALS
<u>25.5'</u>	<u>3'</u>	<u>Bentonite hole plug</u>			
<u>3</u>	<u>0</u>	<u>Top Soil</u>			

7 CONTRACTOR'S OR LANDOWNER'S CERTIFICATION: This water well was plugged under my jurisdiction and was completed on (mo/day/year) 10-12-2021 and this record is true to the best of my knowledge and belief. Kansas Water Well Contractor's License No. 536. This Water Well Record was completed on (mo/day/year) 12-1-2021 under the business name of Fetcher Pump & Well Drilling Inc by (signature) Tom E. Fetcher

Send one white copy to Kansas Department of Health & Environment, Geology Section, 1000 SW Jackson Street, Ste. 420, Topeka, KS 66612-1367. Send one copy to WATER WELL OWNER and retain one for your records. Visit us at <http://www.kdheks.gov/waterwell/index.html> Telephone 785-296-5524.