

**WATER WELL PLUGGING RECORD Form WWC-5P KSA 82a-1212 ID NO.**


**1 LOCATION OF WATER WELL:** Fraction SE 1/4 Sec. 5 Section Number 5 Township Number T 13 S Range Number 20  E  W  
 County: Douglas

Street/Rural Address of Well Location; if unknown, distance & direction from nearest town or intersection: If at owner's address, check here   
1214 E 23rd St  
LAURENCE, KS 66046

**Global Positioning Systems (GPS) information:**  
 Latitude: 38.94221°N (in decimal degrees)  
 Longitude: 95.21835°W (in decimal degrees)  
 Elevation: \_\_\_\_\_  
 Horizontal Datum:  WGS84,  NAD83,  NAD27  
 Collection Method: \_\_\_\_\_

**2 WATER WELL OWNER:** BRYANT Callison Pumper  
 RR#, St. Address, Box #: 1214 E 23rd  
 City, State ZIP Code: LAURENCE, KS 66046

GPS unit (Make/Model: Cell phone)  
 Digital Map/Photo,  Topographic Map,  Land Survey  
 Est. Accuracy:  < 3 m,  3-5 m,  5-15 m,  > 15 m

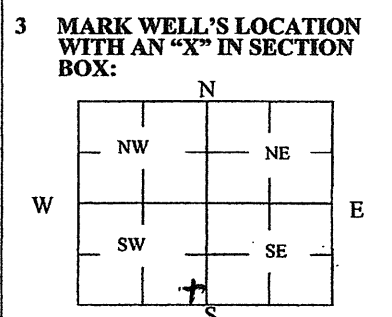

**4 DEPTH OF WELL** 12 ft.  
 WELL'S STATIC WATER LEVEL \_\_\_\_\_ ft.  
 WELL WAS USED AS:  
 Domestic  Public Water Supply  Dewatering  
 Irrigation  Oil Field Water Supply  Monitoring  
 Feedlot  Domestic (Lawn & Garden)  Injection Well  
 Industrial  Air Conditioning  Other \_\_\_\_\_  
 Was a chemical/bacteriological sample submitted to Department? Yes  No

**5 TYPE OF BLANK CASING USED:**  
 Steel  RMP (SR)  Wrought  Fiberglass  Other (Specify below)  
 PVC  ABS  Asbestos-Cement  Concrete Tile  
 Blank casing diameter 10 in. Was casing pulled? Yes  No  If yes, how much \_\_\_\_\_  
 Casing height ~~above~~ or below land surface 3 FT <sup>in.</sup>

**6 GROUT PLUG MATERIAL:**  Neat cement  Cement grout  Bentonite  Other \_\_\_\_\_  
 Grout Plug Intervals: From 12 ft. to 0 ft., From \_\_\_\_\_ ft. to \_\_\_\_\_ ft., From \_\_\_\_\_ ft. to \_\_\_\_\_ ft.

What is the nearest source of possible contamination:  
 Septic tank  Sewer lines  Watertight sewer lines  Lateral lines  Cess pool  
 Seepage pit  Pit privy  Sewage lagoon  Feedyard  Livestock pens  
 Fuel storage  Fertilizer storage  Insecticide storage  Abandoned water well  Oil well/Gas well  
 Other (specify below) Building  
 Direction from well? WEST  
 How many feet? 65'

FROM	TO	PLUGGING MATERIALS	FROM	TO	PLUGGING MATERIALS
<u>12</u>	<u>0</u>	<u>Neat Cement Grout</u>			

**7 CONTRACTOR'S OR LANDOWNER'S CERTIFICATION:** This water well was plugged under my jurisdiction and was completed on (mo/day/year) 6-13-23 and this record is true to the best of my knowledge and belief. Kansas Water Well Contractor's License No. 536. This Water Well Record was completed on (mo/day/year) 6-13-23 under the business name of Patched Pump & Well Drilling, Inc by (signature) Tom Patched

Send one white copy to Kansas Department of Health & Environment, Geology Section, 1000 SW Jackson Street, Ste. 420, Topeka, KS 66612-1367. Send one copy to WATER WELL OWNER and retain one for your records.  
 Visit us at <http://www.kdheks.gov/water-well/index.html> Telephone 785-296-5524.