


1 LOCATION OF WATER WELL: County: **Johnson** Fraction **SW** $\frac{1}{4}$ **NW** $\frac{1}{4}$ **SE** $\frac{1}{4}$ Section Number **24** Township Number **13** S Range Number **21** R **E/W**

Distance and direction from nearest town or city street address of well if located within city?
3 miles south of Clearview City, Kansas

2 WATER WELL OWNER: **Sunflower Army Ammunition Plant** Well No. **MW-81-12**
 RR#, St. Address, Box # **P.O. Box 549 35425 W. 103rd St** Board of Agriculture, Division of Water Resources
 City, State, ZIP Code **DeSoto, Ks. 66018** Application Number: **893.46**

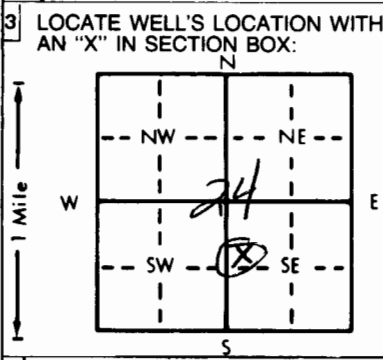

4 DEPTH OF COMPLETED WELL: **35.0** ft. ELEVATION: **893.46**
 Depth(s) Groundwater Encountered 1. ft. 2. ft. 3. ft.
 WELL'S STATIC WATER LEVEL **21.0** ft. below land surface measured on mo/day/yr **8-21-95**
 Pump test data: Well water was ft. after hours pumping gpm
 Est. Yield gpm: Well water was ft. after hours pumping gpm
 Bore Hole Diameter in. to ft., and in. to ft.
 WELL WATER TO BE USED AS:
 1 Domestic 3 Feedlot 6 Oil field water supply 9 Dewatering 12 Other (Specify below)
 2 Irrigation 4 Industrial 7 Lawn and garden only Monitoring well
 Was a chemical/bacteriological sample submitted to Department? Yes No ; If yes, mo/day/yr sample was submitted
 Water Well Disinfected? Yes No

5 TYPE OF BLANK CASING USED:
 1 Steel 3 RMP (SR) 5 Wrought iron 8 Concrete tile CASING JOINTS: Glued Clamped
 2 PVC 4 ABS 7 Fiberglass 9 Other (specify below) Welded
 Blank casing diameter in. to ft., Dia in. to ft., Dia in. to ft.
 Casing height above land surface in., weight lbs./ft. Wall thickness or gauge No.
 TYPE OF SCREEN OR PERFORATION MATERIAL:
 1 Steel 3 Stainless steel 5 Fiberglass 7 PVC 10 Asbestos-cement
 2 Brass 4 Galvanized steel 6 Concrete tile 8 RMP (SR) 11 Other (specify)
 SCREEN OR PERFORATION OPENINGS ARE:
 1 Continuous slot 3 Mill slot 5 Gauzed wrapped 8 Saw cut 11 None (open hole)
 2 Louvered shutter 4 Key punched 6 Wire wrapped 9 Drilled holes
 7 Torch cut 10 Other (specify)
 SCREEN-PERFORATED INTERVALS: From **5.0** ft. to **34.0** ft., From ft. to ft.
 GRAVEL PACK INTERVALS: From **4.0** ft. to **35.0** ft., From ft. to ft.

6 GROUT MATERIAL: 1 Neat cement 2 Cement grout 3 Bentonite Other **microfine cement**
 Grout Intervals: From **3.0** ft. to **35.0** ft., From ft. to ft., From ft. to ft.
 What is the nearest source of possible contamination:
 1 Septic tank 4 Lateral lines 7 Pit privy 10 Livestock pens 14 Abandoned water well
 2 Sewer lines 5 Cess pool 8 Sewage lagoon 11 Fuel storage 15 Oil well/Gas well
 3 Watertight sewer lines 6 Seepage pit 9 Feedyard 12 Fertilizer storage Other (specify below)
 13 Insecticide storage **Landfill**
 Direction from well? **West** How many feet? **50**

FROM	TO	LITHOLOGIC LOG	FROM	TO	PLUGGING INTERVALS
			0.0	3.0	clay soil-tamped
			3.0	35.0	Well abandoned by staged pressure grouting with ADDIMENT-MICROCEM microfine cement. A packer was placed approx. 10' above bottom of the well, 12 to 25 gallons of grout pumped at up to 50 psi. The packer was then moved up 10' and another 12 to 25 gallons of grout pumped at up to 50 psi. The procedure was repeated until the entire well annulus and casing were filled to the surface with grout. All surface features were removed, the well casing was excavated to a depth of 3', the casing cut off, then the hole backfilled with clay soil and tamped.
		CF: KDHE, Bureau of Water SFAAP USACE-MRK-EP-GG			Calculated grout volume = 43.0 gal Actual grout take = 60.0 gal

7 CONTRACTOR'S OR LANDOWNER'S CERTIFICATION: This water well was (1) constructed, (2) reconstructed, or (3) plugged under my jurisdiction and was completed on (mo/day/year) **8-21-95** and this record is true to the best of my knowledge and belief. Kansas Water Well Contractor's License No. **U.S. Army Corps of Engineers - KCD** This Water Well Record was completed on (mo/day/yr) **9-29-95** under the business name of **U.S. Army Corps of Engineers - KCD** by (signature) *Stark J. Jirousek*

OFFICE USE ONLY
T
R
EW
SEC.