


1] LOCATION OF WATER WELL: County: **JOHNSON** Fraction: **NW 1/4 NW 1/4 NE 1/4** Section Number: **11** Township Number: **T 13 S** Range Number: **R 21 E**

Distance and direction from nearest town or city street address of well if located within city?
3 miles East of Eudora on County Rd 4 1/2 on South side

2] WATER WELL OWNER: **ROBERT BARTHOLOMEW**
 RR#, St. Address, Box #: **39493 W 103rd**
 City, State, ZIP Code: **Eudora, KS 66025**
 Board of Agriculture, Division of Water Resources
 Application Number:

3] LOCATE WELL'S LOCATION WITH AN "X" IN SECTION BOX:

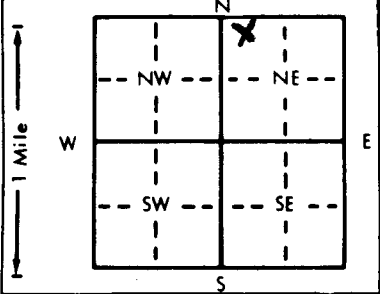

4] DEPTH OF COMPLETED WELL: **43** ft. ELEVATION:

Depth(s) Groundwater Encountered 1. ft. 2. ft. 3. ft.
 WELL'S STATIC WATER LEVEL: **27'** ft. below land surface measured on mo/day/yr **11-20-98**
 Pump test data: Well water was ft. after hours pumping gpm
 Est. Yield gpm: Well water was ft. after hours pumping gpm
 Bore Hole Diameter: in. to ft., and in. to ft.
 WELL WATER TO BE USED AS:
 1 Domestic 3 Feedlot 6 Oil field water supply 9 Dewatering 12 Other (Specify below)
 2 Irrigation 4 Industrial 7 Lawn and garden only 10 Monitoring well
 Was a chemical/bacteriological sample submitted to Department? Yes No X; If yes, mo/day/yr sample was submitted
 Water Well Disinfected? Yes X No

5] TYPE OF BLANK CASING USED:
 1 Steel 3 RMP (SR) 5 Wrought iron 8 Concrete tile CASING JOINTS: Glued X Clamped
 2 PVC 4 ABS 6 Asbestos-Cement 9 Other (specify below) Welded
 Blank casing diameter: **5 1/4** in. to ft., Dia. in. to ft., Dia. in. to ft.
 Casing height above land surface: **18"** in., weight lbs./ft. Wall thickness or gauge No. **SEL 200**


TYPE OF SCREEN OR PERFORATION MATERIAL:
 1 Steel 3 Stainless steel 5 Fiberglass 8 RMP (SR) 10 Asbestos-cement
 2 Brass 4 Galvanized steel 6 Concrete tile 9 ABS 11 Other (specify)
 3 Mill slot 4 Key punched 7 Torch cut 12 None used (open hole)

SCREEN OR PERFORATION OPENINGS ARE:
 1 Continuous slot 2 Mill slot 3 Gauzed wrapped 6 Saw cut 11 None (open hole)
 2 Louvered shutter 4 Key punched 6 Wire wrapped 9 Drilled holes
 3 Mill slot 4 Key punched 7 Torch cut 10 Other (specify)

SCREEN-PERFORATED INTERVALS: From **43** ft. to **33** ft., From ft. to ft.
 GRAVEL PACK INTERVALS: From **43** ft. to **27** ft., From ft. to ft.

6] GROUT MATERIAL: 1 Neat cement 2 Cement grout 3 Bentonite 4 Other
 Grout Intervals: From ft. to ft., From ft. to ft., From ft. to ft.

What is the nearest source of possible contamination:
 1 Septic tank 2 Lateral lines 3 Pit privy 4 Fuel storage 5 Abandoned water well
 2 Sewer lines 5 Cess pool 8 Sewage lagoon 12 Fertilizer storage 15 Oil well/Gas well
 3 Watertight sewer lines 6 Seepage pit 9 Feedyard 13 Insecticide storage 16 Other (specify below)
 Direction from well? **South** How many feet? **125'**

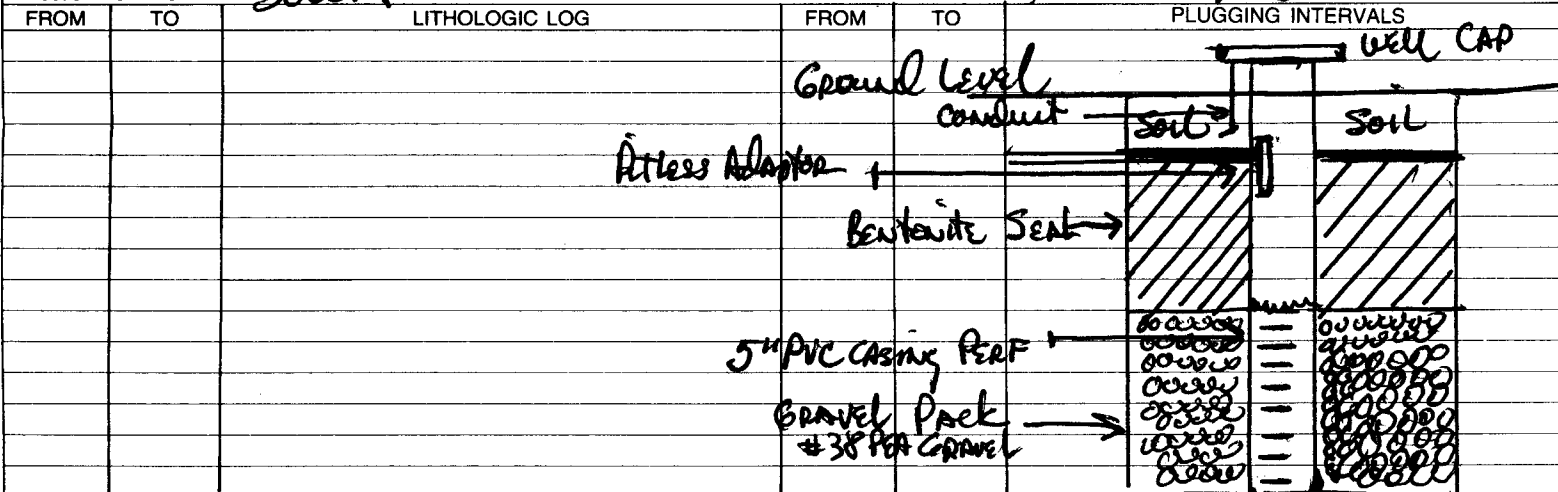

7] CONTRACTOR'S OR LANDOWNER'S CERTIFICATION: This water well was (1) constructed, (2) reconstructed, or (3) plugged under my jurisdiction and was completed on (mo/day/year) **11-20-98** and this record is true to the best of my knowledge and belief. Kansas Water Well Contractor's License No. **536** This Water Well Record was completed on (mo/day/yr) **12-17-98** under the business name of **Patch Pump Well Drilling Inc.** by (signature) **Tom Elathier Jr.**