

Kathy Lawton 864-3431 JR
See well info

T	R	EW	sec 1/4	1/4	1/4	No.
---	---	----	---------	-----	-----	-----

USE TYPEWRITER OR BALL POINT PEN-PRESS FIRMLY, PRINT CLEARLY.


WATER WELL RECORD
 KSA 82a-1201-1215

Kansas State Dept. Of Health
 (Water Well Contractors)
 Forbes-Bldg. 740
 Topeka, Kansas 66620

ABB
NW NW NE

1 Location of well:	County Johnson	Township name	Fraction <i>NW 1/4 NW 1/4 NW 1/4</i> I2	Section number 12 I2	Town number 13 I3	Range number 21 21E
---------------------	--------------------------	---------------	--	--	---------------------------------------	---

Distance and direction from nearest town or city: App. 4 Miles East of Eudora <small>Street address of well location if in city:</small>	3 Owner of well: K.U. Sunflower Research Farm Lawrence Kansas 66044 <small>Address:</small>
---	---

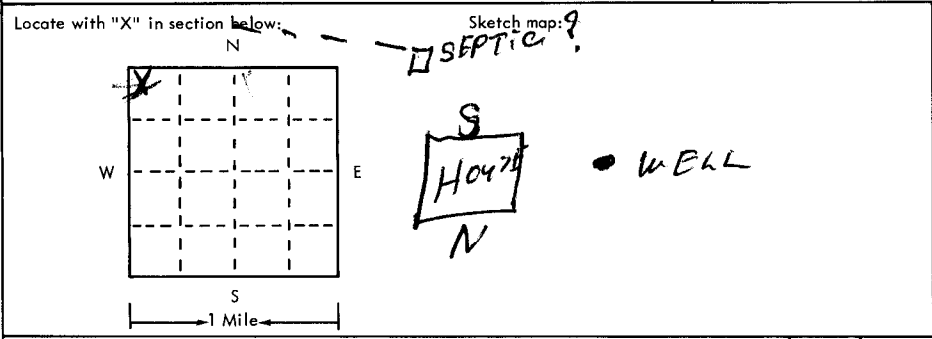

4 Well depth: 33' ft. Date of completion 12-74 <i>25TH</i> Well diameter 7.0 in.
5 <input checked="" type="checkbox"/> Cable tool <input type="checkbox"/> Rotary <input type="checkbox"/> Driven <input type="checkbox"/> Dug <input type="checkbox"/> Hollow rod <input type="checkbox"/> Jetted <input type="checkbox"/> Bored <input type="checkbox"/> Reverse rotary
6 Use: <input checked="" type="checkbox"/> Domestic <input type="checkbox"/> Public supply <input type="checkbox"/> Industry <input type="checkbox"/> Irrigation <input type="checkbox"/> Air conditioning <input type="checkbox"/> Commercial <input type="checkbox"/> Test well <input type="checkbox"/>
7 Casing: Material Steel Height: above/below Threaded <input type="checkbox"/> Welded <input checked="" type="checkbox"/> Surface 36" in. Diam. 6 in. Weight 19 lbs./ft. 34 5" in. to 31 ft. depth Drive shoe? <input type="checkbox"/> Yes <input checked="" type="checkbox"/> No 5" in. to 33 ft. depth

2	Type and color of material	From	To
	Fill Old Building Foundation	0	5
	Yellow Clay	5	31
	Fine Sand Very Fine	31	33
	Lime	33	
	20' 5" Pvc Used for screen 2" Exposed		
	Back Filling Plumbing Electrical to BE		
	Done By others TO CONNECT TO HOUSE		
	Water Sampling was done by Representative of State of Kans		
	(use a second sheet if needed)		

8 Screen: Manufacturer SHOP CARLON Type PVC Dia. 5" Slot/gauze .010 Length 20' Set between 31 ft. and 33 ft. Fittings: NOLE Gravel pack <input type="checkbox"/> Yes <input checked="" type="checkbox"/> No Size range of material
9 Static water level: 21 ft. below land surface Date 12-74 <i>25TH</i>
10 Pumping level below land surfaces: ___ ft. after 4 hrs. pumping ___ g.p.m. ___ ft. after ___ hrs. pumping ___ g.p.m. Estimated maximum yield 9GPM g.p.m.
11 Water sample submitted: <input type="checkbox"/> Yes <input checked="" type="checkbox"/> No Date
12 Well head completion: 36" <input checked="" type="checkbox"/> Pitless adapter 36" inches above grade
13 Well grouted? <input checked="" type="checkbox"/> Yes <input type="checkbox"/> No <input checked="" type="checkbox"/> Neat cement <input type="checkbox"/> Bentonite <input type="checkbox"/> Depth: From 0 ft. to 22 ft.
14 Nearest source of possible contamination: ft. 100 Direction East Type Sepitic Well disinfected upon completion? <input checked="" type="checkbox"/> Yes <input type="checkbox"/> No
15 Pump: <input checked="" type="checkbox"/> Not installed Manufacturer's name Goulds Model number 5ES HP 1/4 Volts 230 Length of drop pipe 31 ft. capacity 5 g.m.p. Type: <input checked="" type="checkbox"/> Submersible <input type="checkbox"/> Turbine <input type="checkbox"/> Jet <input type="checkbox"/> Reciprocating <input type="checkbox"/> Centrifugal <input type="checkbox"/> Other

16 Remarks: elevation 934. Topography: <input type="checkbox"/> Hill <input checked="" type="checkbox"/> Slope <input type="checkbox"/> Upland <input type="checkbox"/> Valley <i>Well filled with sand No longer used. They get water from sunflower farm past few years. 3/10/81 jd</i>

17 Water well contractor's certification: This well was drilled under my jurisdiction and this report is true to the best of my knowledge and belief. Jungmann Bros Drilling Co Business name License No. 119 Address Cardondale Signed <i>[Signature]</i> Date 12-74 <i>25TH</i> Authorized representative

Forward the white, blue and pink copies to the Kansas State Dept. Of Health.

Form WWC-5

BR = 901

□ = 913