


1 LOCATION OF WATER WELL:	Fraction	Section Number	Township Number	Range Number
County: <u>Johnson</u>	NE ¼ NW ¼ SW ¼	12	T 13 S	R 21 E/W

Distance and direction from nearest town or city street address of well if located within city?  
2 miles SW of DeSoto

2 WATER WELL OWNER: Sunflower Army Ammunition Plant  
 RR#, St. Address, Box #: P.O. Box 549 Board of Agriculture, Division of Water Resources  
 City, State, ZIP Code: DeSoto, Kansas 66018 Application Number:

3 LOCATE WELL'S LOCATION WITH AN "X" IN SECTION BOX:

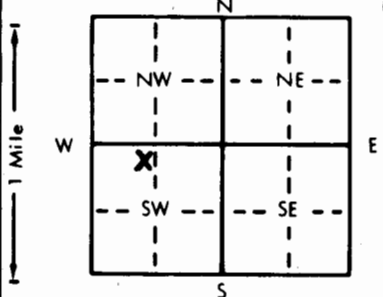

4 DEPTH OF COMPLETED WELL: 32 ft. ELEVATION: 895  
 Depth(s) Groundwater Encountered 1. 20 ft. 2. 26 ft. 3. 32 ft.  
 WELL'S STATIC WATER LEVEL 26 ft. below land surface measured on mo/day/yr 1-24-85  
 Bore Hole Diameter 8 in. to 32 ft., and 8 in. to 32 ft.  
 WELL WATER TO BE USED AS:  
 1 Domestic 3 Feedlot 6 Oil field water supply 9 Dewatering 11 Injection well  
 2 Irrigation 4 Industrial 7 Lawn and garden only 10 Observation well Monitoring  
 Was a chemical/bacteriological sample submitted to Department? Yes No X; If yes, mo/day/yr sample was submitted  
 Water Well Disinfected? Yes X No

5 TYPE OF BLANK CASING USED:  
 1 Steel 2 PVC 3 RMP (SR) 4 ABS 5 Wrought iron 6 Asbestos-Cement 7 Fiberglass 8 Concrete tile 9 Other (specify below) CASING JOINTS: Glued Clamped Welded Threaded X  
 Casing height above land surface 24 in., weight 24 lbs./ft. Wall thickness or gauge No. Sched. 80

TYPE OF SCREEN OR PERFORATION MATERIAL:  
 1 Steel 2 Brass 3 Stainless steel 4 Galvanized steel 5 Fiberglass 6 Concrete tile 7 PVC 8 RMP (SR) 9 ABS 10 Asbestos-cement 11 Other (specify) 12 None used (open hole)  
 SCREEN OR PERFORATION OPENINGS ARE:  
 1 Continuous slot 2 Louvered shutter 3 Mill slot 4 Key punched 5 Gauzed wrapped 6 Wire wrapped 7 Torch cut 8 Saw cut 9 Drilled holes 11 None (open hole) 10 Other (specify)


6 GROUT MATERIAL: 1 Neat cement 2 Cement grout 3 Bentonite 4 Other  
 What is the nearest source of possible contamination:  
 1 Septic tank 2 Sewer lines 3 Watertight sewer lines 4 Lateral lines 5 Cess pool 6 Seepage pit 7 Pit privy 8 Sewage lagoon 9 Feedyard 10 Livestock pens 11 Fuel storage 12 Fertilizer storage 13 Insecticide storage 14 Abandoned water well 15 Oil well/Gas well 16 Other (specify below)  
 Direction from well? all around How many feet? 50

FROM	TO	LITHOLOGIC LOG	FROM	TO	LITHOLOGIC LOG
0.0	1.6	Topsoil			
1.6	5.0	3 Brown silty clay			
5.0	6.8	20 Brown limestone weathered			
6.8	8.0	01 Brown shaly clay			
8.0	12.5	20 Brown limestone weathered			
12.5	17.0	23 Brown shaly sandstone			
17.0	19.0	19 Gray shale			
19.0	30.0	20 Gray limestone thin shale seams, hard			
30.0	Total	Depth			

7 CONTRACTOR'S OR LANDOWNER'S CERTIFICATION: This water well was 1 constructed, (2) reconstructed, or (3) plugged under my jurisdiction and was completed on (mo/day/year) 2/1/85 1/24/85 and this record is true to the best of my knowledge and belief. Kansas Water Well Contractor's License No. 102 This Water Well Record was completed on (mo/day/yr) 2/1/85 under the business name of Layne-Western Company, Inc. by (signature) David D. Smith

INSTRUCTIONS: Use typewriter or ball point pen, PLEASE PRESS FIRMLY and PRINT clearly. Please fill in blanks, underline or circle the correct answers. Send top three copies to Kansas Department of Health and Environment, Division of Environment, Environmental Geology Section, Topeka, KS 66620. Send one to WATER WELL OWNER and retain one for your records.

OFFICE USE ONLY  
T  
R  
EM  
SEC.  
1/4  
1/4  
1/4