


1 LOCATION OF WATER WELL: Fraction NW $\frac{1}{4}$ $\frac{1}{4}$ $\frac{1}{4}$ Section Number 28-13-21 Township Number 13-5 Range Number 21-E E/W

County: Douglas

Distance and direction from nearest town or city street address of well if located within city?
2 1/2 miles south of Eudora

2 WATER WELL OWNER: 2115 N 1100 Rd
 RR #, St. Address, Box #: _____
 City, State, ZIP Code: Tim Neis Eudora, MO Board of Agriculture, Division of Water Resources
 Application Number: _____

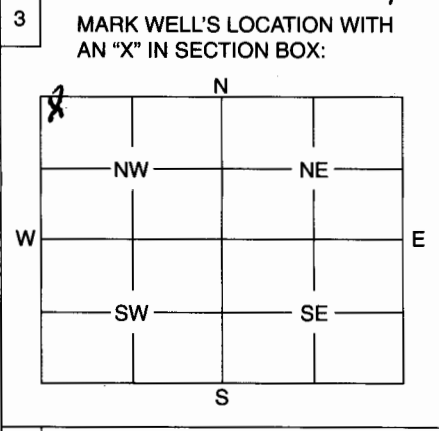

4 DEPTH OF WELL 32 ft.
 WELL'S STATIC WATER LEVEL 22 ft.

WELL WAS USED AS:

1 Domestic	5 Public Water Supply	9 Dewatering
2 Irrigation	6 Oil Field Water Supply	10 Monitoring Well
3 Feedlot	7 Domestic (Lawn & Garden)	11 Injection Well
4 Industrial	8 Air Conditioning	12 Other <u>Not in Service</u>

Was a chemical / bacteriological sample submitted to Department? Yes X..... No

If yes, mo/day/yr sample was submitted

Water Well Disinfected: Yes X..... No

5 TYPE OF BLANK CASING USED:

1 Steel	3 RMP (SR)	5 Wrought	7 Fiberglass	9 Other (Specify below)
2 PVC	4 ABS	6 Asbestos-Cement	8 Concrete Tile	<u>dup well</u>

Blank casing diameter in. Was casing pulled? Yes No If yes, how much

Casing height above or below land surface in.

6 GROUT PLUG MATERIAL: 1 Neat cement 2 Cement grout 3 Bentonite 4 Other

Grout Plug Intervals: From ft. to ft., From 17.5 ft. to 12 ft., From to ft.

What is the nearest source of possible contamination:

<u>1</u> Septic tank	6 Seepage pit	11 Fuel storage	16 Other (specify below)
2 Sewer lines	7 Pit privy	12 Fertilizer storage	
3 Watertight sewer lines	8 Sewage lagoon	13 Insecticide storage	
4 Lateral lines	9 Feedyard	14 Abandoned water well	
5 Cess pool	10 Livestock pens	15 Oil well/Gas well	

Direction from well? N.E. 1/4 How many feet? 60'

FROM	TO	PLUGGING MATERIALS
<u>22</u>	<u>22</u>	<u>50# 4</u>
<u>22</u>	<u>17.5</u>	<u>subsoil</u>
<u>17.5</u>	<u>12.5</u>	<u>9 bags bentonite</u>
<u>12.5</u>	<u>2.14</u>	<u>Top Soil</u>

7 CONTRACTOR'S OF LANDOWNER'S CERTIFICATION: This water well was plugged under my jurisdiction and was completed on (mo/day/year) 6-8-06 and this record is true to the best of my knowledge and belief. Kansas Water Well Contractor's License No. _____ This Water Well Record was completed on (mo/day/year) _____ under the business name of _____ by (signature) [Signature]

INSTRUCTIONS: Use typewriter or ball point pen. Please press firmly and print clearly. Please fill in blanks, underline or circle the correct answers. Send top three copies to Kansas Department of Health and Environment, Bureau of Water, Geology Section, 1000 SW Jackson St., Ste. 420, Topeka, Kansas 66612-1367. Telephone: 785/296-5522. Send one to Water Well Owner and retain one for your records.