


Well #2

1	LOCATION OF WATER WELL:	Fraction	Section Number	Township Number	Range Number
County:	<u>Douglas</u>	$\frac{1}{4}$ NW $\frac{1}{4}$ SE $\frac{1}{4}$	<u>5</u>	<u>13</u>	<u>21</u> E/W

Distance and direction from nearest town or city street address of well if located within city?  
NEAR City WATER PLANT - Well is IN Well House AT THE Gate WATER Jockey Building

2	WATER WELL OWNER: <u>City of Eudora</u>	Board of Agriculture, Division of Water Resources
RR #, St. Address, Box #:	<u>101 W. 5</u>	Application Number: <u>N/C</u>
City, State, ZIP Code:	<u>Eudora, KS 66025</u>	

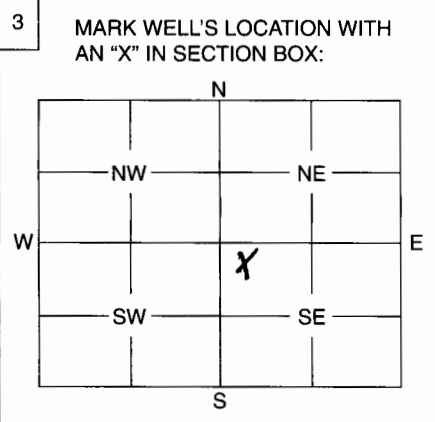

4 DEPTH OF WELL ..... 68.7 ft.

WELL'S STATIC WATER LEVEL ..... 29 ft.

WELL WAS USED AS:

1 Domestic	<u>5 Public Water Supply</u>	9 Dewatering
2 Irrigation	6 Oil Field Water Supply	10 Monitoring Well
3 Feedlot	7 Domestic (Lawn & Garden)	11 Injection Well
4 Industrial	8 Air Conditioning	12 Other .....

Was a chemical / bacteriological sample submitted to Department? Yes ..... No X.....  
 If yes, mo/day/yr sample was submitted .....

Water Well Disinfected: Yes X..... No .....

5 TYPE OF BLANK CASING USED:

<u>1 Steel</u>	3 RMP (SR)	5 Wrought	7 Fiberglass	9 Other (Specify below)
2 PVC	4 ABS	6 Asbestos-Cement	8 Concrete Tile	

Blank casing diameter ..... 12 in. Was casing pulled? Yes ..... No..... If yes, how much .....

Casing height above or below land surface ..... 4 FT in.

6 GROUT PLUG MATERIAL: 1 Neat cement 2 Cement grout 3 Bentonite 4 Other .....

Grout Plug Intervals: From 69 ft. to GL ft., From GL ft. to 4' AGL ft., From ..... to ..... ft.

What is the nearest source of possible contamination:

1 Septic tank	6 Seepage pit	11 Fuel storage	<u>16 Other (specify below)</u>
2 Sewer lines	7 Pit privy	12 Fertilizer storage	<u>City WATER PLANT</u>
3 Watertight sewer lines	8 Sewage lagoon	13 Insecticide storage	
4 Lateral lines	9 Feedyard	14 Abandoned water well	
5 Cess pool	10 Livestock pens	15 Oil well/Gas well	

Direction from well? ..... WEST ..... How many feet? ..... 400' .....

FROM	TO	PLUGGING MATERIALS
<u>69'</u>	<u>Ground Level</u>	<u>NEAT CEMENT</u>
<u>GL</u>	<u>TO top OF CASING IN Well HOUSE</u>	<u>NEAT CEMENT</u>

7 CONTRACTOR'S OF LANDOWNER'S CERTIFICATION: This water well was plugged under my jurisdiction and was completed on (mo/day/year) ..... 8-9-06 ..... and this record is true to the best of my knowledge and belief. Kansas Water Well Contractor's License No. 102 This Water Well Record was completed on (mo/day/year) 3-1-07 under the business name of Layne Western Co. by (signature) Joe Haverstick, DRC

INSTRUCTIONS: Use typewriter or ball point pen. Please press firmly and print clearly. Please fill in blanks, underline or circle the correct answers. Send top three copies to Kansas Department of Health and Environment, Bureau of Water, Geology Section, 1000 SW Jackson St., Ste. 420, Topeka, Kansas 66612-1367. Telephone: 785/296-5522. Send one to Water Well Owner and retain one for your records.