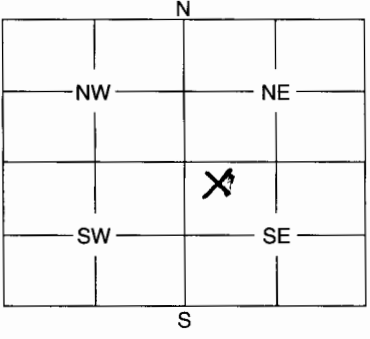


1	LOCATION OF WATER WELL: County: Douglas	Fraction 1/4 NW 1/4 SE 1/4	Section Number 5	Township Number 13	Range Number 21	E/W
---	---	--------------------------------------	----------------------------	------------------------------	---------------------------	-----

Distance and direction from nearest town or city street address of well if located within city?
NEAR City water plant from City BARN 172' N. 36' WEST

2	WATER WELL OWNER: City of Eudora RR #, St. Address, Box #: 101 W. 5 City, State, ZIP Code: Eudora, KS 66025	Board of Agriculture, Division of Water Resources Application Number: N/C
---	--	---

3	MARK WELL'S LOCATION WITH AN "X" IN SECTION BOX: 	4	DEPTH OF WELL 73 ft. WELL'S STATIC WATER LEVEL 24.5 ft. WELL WAS USED AS: <ul style="list-style-type: none"> 1 Domestic 2 Irrigation 3 Feedlot 4 Industrial 5 Public Water Supply 6 Oil Field Water Supply 7 Domestic (Lawn & Garden) 8 Air Conditioning 9 Dewatering 10 Monitoring Well 11 Injection Well 12 Other
---	--	---	---

Was a chemical / bacteriological sample submitted to Department? Yes **No**
If yes, mo/day/yr sample was submitted

Water Well Disinfected: **Yes** No

5	TYPE OF BLANK CASING USED: <input checked="" type="checkbox"/> 1 Steel <input type="checkbox"/> 3 RMP (SR) <input type="checkbox"/> 5 Wrought <input type="checkbox"/> 7 Fiberglass <input type="checkbox"/> 9 Other (Specify below) <input type="checkbox"/> 2 PVC <input type="checkbox"/> 4 ABS <input type="checkbox"/> 6 Asbestos-Cement <input type="checkbox"/> 8 Concrete Tile
---	--

Blank casing diameter **12"** in. Was casing pulled? Yes **No** If yes, how much

Casing height above or below land surface

6	GROUT PLUG MATERIAL: <input checked="" type="checkbox"/> 1 Neat cement <input type="checkbox"/> 2 Cement grout <input type="checkbox"/> 3 Bentonite <input type="checkbox"/> 4 Other
---	--

GROUT PLUG INTERVALS: From ft. to ft., From ft. to ft., From to ft.

What is the nearest source of possible contamination:

- 1 Septic tank
- 2 Sewer lines
- 3 Watertight sewer lines
- 4 Lateral lines
- 5 Cess pool
- 6 Seepage pit
- 7 Pit privy
- 8 Sewage lagoon
- 9 Feedyard
- 10 Livestock pens
- 11 Fuel storage
- 12 Fertilizer storage
- 13 Insecticide storage
- 14 Abandoned water well
- 15 Oil well/Gas well
- 16 **Other (specify below)**
City water plant

Direction from well? **EAST** How many feet? **200**

FROM	TO	PLUGGING MATERIALS
73'	20'	Chlorinated Sand
20'	3'	NEAT CEMENT
3'	0'	SURFACE MATERIAL

7	CONTRACTOR'S OF LANDOWNER'S CERTIFICATION: This water well was plugged under my jurisdiction and was completed on (mo/day/year) 8-9-06 and this record is true to the best of my knowledge and belief. Kansas Water Well Contractor's License No. 102 This Water Well Record was completed on (mo/day/year) 3-1-07 under the business name of LAYNE WESTERN CO. KANSAS CITY, KS 66106 by (signature) Joe Hruska/DRC
---	--

INSTRUCTIONS: Use typewriter or ball point pen. Please press firmly and print clearly. Please fill in blanks, underline or circle the correct answers. Send top three copies to Kansas Department of Health and Environment, Bureau of Water, Geology Section, 1000 SW Jackson St., Ste. 420, Topeka, Kansas 66612-1367. Telephone: 785/296-5522. Send one to Water Well Owner and retain one for your records.