


1	LOCATION OF WATER WELL:	Fraction	Section Number	Township Number	Range Number
County:	JOHNSON	NE 1/4 SE 1/4 6E 1/4	24	T13S	R21

Distance and direction from nearest town or city street address of well if located within city:

2 WATER WELL OWNER:

RR #, St. Address, Box #: _____
 City, State, ZIP Code: _____

Board of Agriculture, Division of Water Resources
 Application Number: _____

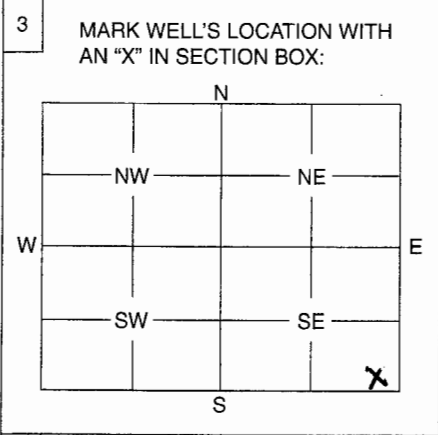

4 DEPTH OF WELL 37.70 ft.
 WELL'S STATIC WATER LEVEL 28.80 ft.

WELL WAS USED AS:

1 Domestic	5 Public Water Supply	9 Dewatering
2 Irrigation	6 Oil Field Water Supply	10 Monitoring Well
3 Feedlot	7 Domestic (Lawn & Garden)	11 Injection Well
4 Industrial	8 Air Conditioning	12 Other PIEZOMETER

Was a chemical / bacteriological sample submitted to Department? Yes No
 If yes, mo/day/yr sample was submitted

Water Well Disinfected: Yes No

5 TYPE OF BLANK CASING USED:

1 Steel	3 RMP (SR)	5 Wrought	7 Fiberglass	9 Other (Specify below)
<input checked="" type="radio"/> PVC	4 ABS	6 Asbestos-Cement	8 Concrete Tile	

Blank casing diameter 1 in. Was casing pulled? Yes No If yes, how much ALL - 37.7
 Casing height above or below land surface 12.11 in.

6 GROUT PLUG MATERIAL: 1 Neat cement 2 Cement grout 3 Bentonite 4 Other CEMENT-BENTONITE GROUT

Grout Plug Intervals: From 37.70 ft. to 3.0 ft., From ft. to ft., From to ft.

What is the nearest source of possible contamination:

1 Septic tank	6 Seepage pit	11 Fuel storage	16 Other (specify below)
2 Sewer lines	7 Pit privy	12 Fertilizer storage	
3 Watertight sewer lines	8 Sewage lagoon	13 Insecticide storage	
4 Lateral lines	9 Feedyard	14 Abandoned water well	
5 Cess pool	10 Livestock pens	15 Oil well/Gas well	

Direction from well? How many feet?

FROM	TO	PLUGGING MATERIALS
37.70	3.0	CEMENT BENTONITE GROUT
3.0	0.0	NATIVE SILTY CLAY

7 CONTRACTOR'S OF LANDOWNER'S CERTIFICATION: This water well was plugged under my jurisdiction and was completed on (mo/day/year) 12/21/07 and this record is true to the best of my knowledge and belief. Kansas Water Well Contractor's License No. 614 This Water Well Record was completed on (mo/day/year) under the business name of TECHN. TECH. by (signature) William Stafford

INSTRUCTIONS: Use typewriter or ball point pen. Please press firmly and print clearly. Please fill in blanks, underline or circle the correct answers. Send top three copies to Kansas Department of Health and Environment, Bureau of Water, Geology Section, 1000 SW Jackson St., Ste. 420, Topeka, Kansas 66612-1367. Telephone: 785/296-5522. Send one to Water Well Owner and retain one for your records.



TETRA TECH

January 16, 2008

Kansas Department of Health and Environment
Bureau of Water
Geology Section
1000 SW Jackson Street
Suite 420
Topeka, KS 66612-1367

RE: Submittal of Forms WWC-5P

Dear Sir or Madame:

Please find enclosed completed WWC-5P forms for the abandonment of four temporary piezometers located at the former Sunflower Army Ammunition Plant in DeSoto, KS.

If you should have any questions please contact me at (865) 988-4928.

Sincerely,

Allan T. Jenkins, P.G.
Tetra Tech Inc.
800 Oak Ridge Turnpike
Suite A-600
Oak Ridge, TN 37830

Enclosure

Cc: Mr. Tony Spaar, U.S. Army, Former SFAAP, DeSoto, KS
Mr. Mike Albert, Tt
Bill Stafford, Tt

RECEIVED

JAN 22 2008

BUREAU OF WATER

800 Oak Ridge Turnpike, Suite A-600, Oak Ridge, TN 37830
Tel 865.483.9900 Fax 865.483.2014
www.tetrattech.com