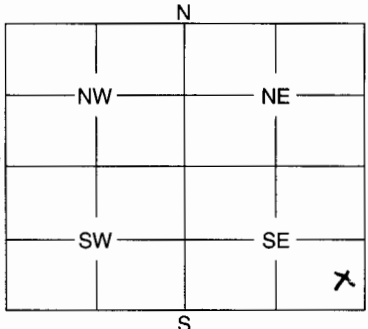


1	LOCATION OF WATER WELL: County: <b>JOTHGON</b>	Fraction <b>NE 1/4 SE 1/4 SE 1/4</b>	Section Number <b>24</b>	Township Number <b>T13S</b>	Range Number <b>R 21 (EW)</b>
---	---	---	-----------------------------	--------------------------------	----------------------------------

Distance and direction from nearest town or city street address of well if located within city?

2	WATER WELL OWNER: RR #, St. Address, Box #: City, State, ZIP Code :	Board of Agriculture, Division of Water Resources Application Number:
---	---	--

3	MARK WELL'S LOCATION WITH AN "X" IN SECTION BOX: 	4	DEPTH OF WELL ..... <b>34.00</b> ..... ft. WELL'S STATIC WATER LEVEL ..... <b>26.80</b> ..... ft. WELL WAS USED AS: 1 Domestic                      5 Public Water Supply                      9 Dewatering 2 Irrigation                      6 Oil Field Water Supply                      10 Monitoring Well 3 Feedlot                          7 Domestic (Lawn & Garden)                      11 Injection Well 4 Industrial                      8 Air Conditioning <b>(2) Other: PIEZOMETER</b> Was a chemical / bacteriological sample submitted to Department? Yes ..... No <input checked="" type="checkbox"/> If yes, mo/day/yr sample was submitted ..... Water Well Disinfected: Yes <input checked="" type="checkbox"/> No .....
---	---	---	--

5	TYPE OF BLANK CASING USED: 1 Steel      3 RMP (SR)      5 Wrought      7 Fiberglass      9 Other (Specify below) <b>(2) PVC</b> 4 ABS      6 Asbestos-Cement      8 Concrete Tile Blank casing diameter ..... in.      Was casing pulled? Yes <input checked="" type="checkbox"/> No .....      If yes, how much <b>ALL - 34.0'</b> Casing height above or below land surface ..... <b>12"</b> ..... in.
---	--

6	GROUT PLUG MATERIAL:      1 Neat cement      2 Cement grout      3 Bentonite <b>(4) Other: CEMENT BENTONITE GROUT</b> Grout Plug Intervals:      From <b>34.0</b> ft. to <b>3.0</b> ft.,      From ..... ft. to ..... ft.,      From ..... to ..... ft. What is the nearest source of possible contamination: 1 Septic tank                      6 Seepage pit                      11 Fuel storage                      16 Other (specify below) 2 Sewer lines                      7 Pit privy                          12 Fertilizer storage 3 Watertight sewer lines                      8 Sewage lagoon                      13 Insecticide storage 4 Lateral lines                      9 Feedyard                          14 Abandoned water well 5 Cess pool                          10 Livestock pens                      15 Oil well/Gas well Direction from well? .....      How many feet? .....
---	--

FROM	TO	PLUGGING MATERIALS
34.00	3.00	CEMENT BENTONITE GROUT
3.00	0.00	NATIVE SILTY CLAY

7	CONTRACTOR'S OF LANDOWNER'S CERTIFICATION: This water well was plugged under my jurisdiction and was completed on (mo/day/year) <b>12/21/07</b> ..... and this record is true to the best of my knowledge and belief. Kansas Water Well Contractor's License No. <b>614</b> ..... This Water Well Record was completed on (mo/day/year) ..... under the business name of <b>TECH TECH</b> by (signature) <b>William Stafford</b>
---	--

INSTRUCTIONS: Use typewriter or ball point pen. Please press firmly and print clearly. Please fill in blanks, underline or circle the correct answers. Send top three copies to Kansas Department of Health and Environment, Bureau of Water, Geology Section, 1000 SW Jackson St., Ste. 420, Topeka, Kansas 66612-1367. Telephone: 785/296-5522. Send one to Water Well Owner and retain one for your records.



**TETRA TECH**

January 16, 2008

Kansas Department of Health and Environment  
Bureau of Water  
Geology Section  
1000 SW Jackson Street  
Suite 420  
Topeka, KS 66612-1367

RE: Submittal of Forms WWC-5P

Dear Sir or Madame:

Please find enclosed completed WWC-5P forms for the abandonment of four temporary piezometers located at the former Sunflower Army Ammunition Plant in DeSoto, KS.

If you should have any questions please contact me at (865) 988-4928.

Sincerely,

Allan T. Jenkins, P.G.  
Tetra Tech Inc.  
800 Oak Ridge Turnpike  
Suite A-600  
Oak Ridge, TN 37830

Enclosure

Cc: Mr. Tony Spaar, U.S. Army, Former SFAAP, DeSoto, KS  
Mr. Mike Albert, Tt  
Bill Stafford, Tt

**RECEIVED**

**JAN 22 2008**

**BUREAU OF WATER**

800 Oak Ridge Turnpike, Suite A-600, Oak Ridge, TN 37830  
Tel 865.483.9900 Fax 865.483.2014  
www.tetrattech.com