

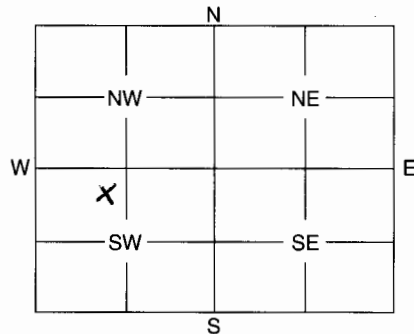
1	LOCATION OF WATER WELL:	Fraction	Section Number	Township Number	Range Number
	County: <u>JOHNSON</u>	<u>NE 1/4 NW 1/4 SW 1/4</u>	<u>24</u>	<u>T13S</u>	<u>R21</u> <u>EW</u>

Distance and direction from nearest town or city street address of well if located within city?

2 WATER WELL OWNER:

RR #, St. Address, Box #:
City, State, ZIP Code :Board of Agriculture, Division of Water Resources
Application Number:

3 MARK WELL'S LOCATION WITH AN "X" IN SECTION BOX:

4 DEPTH OF WELL 13.60 ft.WELL'S STATIC WATER LEVEL 8.50 ft.

WELL WAS USED AS:

- | | | |
|--------------|----------------------------|----------------------------|
| 1 Domestic | 5 Public Water Supply | 9 Dewatering |
| 2 Irrigation | 6 Oil Field Water Supply | 10 Monitoring Well |
| 3 Feedlot | 7 Domestic (Lawn & Garden) | 11 Injection Well |
| 4 Industrial | 8 Air Conditioning | 12 Other <u>Piezometer</u> |

Was a chemical / bacteriological sample submitted to Department? Yes No ✓
If yes, mo/day/yr sample was submittedWater Well Disinfected: Yes ✓ No

5 TYPE OF BLANK CASING USED:

- | | | | | |
|---------|------------|-------------------|-----------------|-------------------------|
| 1 Steel | 3 RMP (SR) | 5 Wrought | 7 Fiberglass | 9 Other (Specify below) |
| 2 PVC | 4 ABS | 6 Asbestos-Cement | 8 Concrete Tile | <u>Piezometer</u> |

Blank casing diameter in. Was casing pulled? Yes ✓ No If yes, how much 13.6'
Casing height above or below land surface 3 in.6 GROUT PLUG MATERIAL: 1 Neat cement 2 Cement grout 3 Bentonite 4 Other CEMENT BENTONITE GROUT
Grout Plug Intervals: From 13.6 ft. to 3.0 ft., From ft. to ft., From ft. to ft.

What is the nearest source of possible contamination:

- | | | | |
|--------------------------|-------------------|-------------------------|--------------------------|
| 1 Septic tank | 6 Seepage pit | 11 Fuel storage | 16 Other (specify below) |
| 2 Sewer lines | 7 Pit privy | 12 Fertilizer storage | |
| 3 Watertight sewer lines | 8 Sewage lagoon | 13 Insecticide storage | |
| 4 Lateral lines | 9 Feedyard | 14 Abandoned water well | |
| 5 Cess pool | 10 Livestock pens | 15 Oil well/Gas well | |

Direction from well? How many feet?

FROM	TO	PLUGGING MATERIALS
13.6'	3.0'	CEMENT BENTONITE GROUT
3.0	9.0'	NATIVE SILTY CLAY

7 CONTRACTOR'S OF LANDOWNER'S CERTIFICATION: This water well was plugged under my jurisdiction and was completed on (mo/day/year) 12/21/07 and this record is true to the best of my knowledge and belief. Kansas Water Well Contractor's License No. 614 This Water Well Record was completed on (mo/day/year) under the business name of Tetra Tech by (signature) William Stoffer

INSTRUCTIONS: Use typewriter or ball point pen. Please press firmly and print clearly. Please fill in blanks, underline or circle the correct answers. Send top three copies to Kansas Department of Health and Environment, Bureau of Water, Geology Section, 1000 SW Jackson St., Ste. 420, Topeka, Kansas 66612-1367. Telephone: 785/296-5522. Send one to Water Well Owner and retain one for your records.



TETRA TECH

January 16, 2008

Kansas Department of Health and Environment
Bureau of Water
Geology Section
1000 SW Jackson Street
Suite 420
Topeka, KS 66612-1367

RE: Submittal of Forms WWC-5P

Dear Sir or Madame:

Please find enclosed completed WWC-5P forms for the abandonment of four temporary piezometers located at the former Sunflower Army Ammunition Plant in DeSoto, KS.

If you should have any questions please contact me at (865) 988-4928.

Sincerely,

Allan T. Jenkins, P.G.
Tetra Tech Inc.
800 Oak Ridge Turnpike
Suite A-600
Oak Ridge, TN 37830

Enclosure

Cc: Mr. Tony Spaar, U.S. Army, Former SFAAP, DeSoto, KS
Mr. Mike Albert, Tt
Bill Stafford, Tt

RECEIVED

JAN 22 2008

BUREAU OF WATER

800 Oak Ridge Turnpike, Suite A-600, Oak Ridge, TN 37830
Tel 865.483.9900 Fax 865.483.2014
www.tetratech.com