


1 LOCATION OF WATER WELL:	Fraction	Section Number	Township Number	Range Number
County: <u>Johnson</u>	$\frac{1}{4}$ $\frac{1}{4}$ <u>NW</u> $\frac{1}{4}$	<u>18</u>	T <u>13</u> S	R <u>22</u> <u>E</u>

Distance and direction from nearest town or city street address of well if located within city?
Well 26MW002A at Sunflower AAP near DeSoto KS

2 WATER WELL OWNER: USACE % Burns & McDonnell
RR#, St. Address, Box #: 9400 Ward Parkway
City, State, ZIP Code: Kansas City MO 64114

Board of Agriculture, Division of Water Resources
Application Number:

3 LOCATE WELL'S LOCATION WITH AN "X" IN SECTION BOX: 4 DEPTH OF COMPLETED WELL: 9.5 ft. ELEVATION: 9.3
Depth(s) Groundwater Encountered 1 9.3 ft 2 ft 3 ft

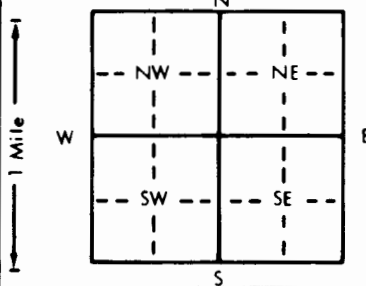

4) DEPTH OF COMPLETED WELL 9.5 ft. ELEVATION: _____

Depth(s) Groundwater Encountered 1. 9.3 ft. 2. _____ ft. 3. _____ ft.

WELL'S STATIC WATER LEVEL 2 ft. below land surface measured on mo/day/yr 2/24/97

Pump test data: Well water was _____ ft. after _____ hours pumping _____ gpm

Est. Yield _____ gpm Well water was _____ ft. after _____ hours pumping _____ gpm

Bore Hole Diameter 10 in. to 9.5 ft. and _____ in. to _____ ft.

WELL WATER TO BE USED AS:

1 Domestic	3 Feedlot	6 Oil field water supply	9 Dewatering	12 Other (Specify below)
2 Irrigation	4 Industrial	7 Lawn and garden only	10 Monitoring well	

Was a chemical/bacteriological sample submitted to Department? Yes _____ No X If yes, mo/day/yr sample was submitted _____

Water Well Disinfected? Yes _____ No X

5 TYPE OF BLANK CASING USED: 5 Wrought iron 8 Concrete tile CASING JOINTS: Glued Clamped
1 Steel 3 RMP (SR) 6 Asbestos-Cement 9 Other (specify below) Welded
② PVC 4 ABS 7 Fiberglass Threaded. X
Blank casing diameter 2 in. to 5.5 ft. Dia in. to . ft. Dia in. to . ft.
Casing height above land surface 30 in. weight lbs./ft. Wall thickness or gauge No. Sch 40

TYPE OF SCREEN OR PERFORATION MATERIAL:

1 Steel	3 Stainless steel	5 Fiberglass	7 PVC	10 Asbestos-cement
2 Brass	4 Galvanized steel	6 Concrete tile	8 RMP (SR)	11 Other (specify)
			9 ABS	12 None used (open hole)

SCREEN OR PERFORATION OPENINGS ARE:

1 Continuous slot	3 Mill slot	5 Gauzed wrapped	8 Saw cut	11 None (open hole)
2 Louvered shutter	4 Key punched	6 Wire wrapped	9 Drilled holes	
		7 Torch cut	10 Other (specify)	

SCREEN-PERFORATED INTERVALS:	From	5.5	ft. to	9.5	ft.	From		ft. to		ft.
	From		ft. to		ft.	From		ft. to		ft.
GRAVEL PACK INTERVALS:	From	4.5	ft. to	9.5	ft.	From		ft. to		ft.
	From		ft. to		ft.	From		ft. to		ft.

6 GROUT MATERIAL: 1 Neat cement 2 Cement grout 3 Bentonite 4 Other
Grout Intervals: From 2 ft. to 4.5 ft., From ft. to ft., From ft. to ft.

What is the nearest source of possible contamination:

1 Septic tank	4 Lateral lines	7 Pit privy	10 Livestock pens	14 Abandoned water well
2 Sewer lines	5 Cess pool	8 Sewage lagoon	11 Fuel storage	15 Oil well/Gas well
3 Watertight sewer lines	6 Seepage pit	9 Feedyard	12 Fertilizer storage	16 Other (specify below)
			13 Insecticide storage	Ammunition plant

[illegible]

7. CONTRACTOR'S OR LANDOWNER'S CERTIFICATION: This water well was (1) constructed, (2) reconstructed, or (3) plugged under my jurisdiction and was completed on (mo/day/year) 2/24/97 and this record is true to the best of my knowledge and belief. Kansas Water Well Contractor's License No. 570 This Water Well Record was completed on (mo/day/yr) 6/7/97 under the business name of AQUADRILL, INC by (signature) [Signature]