


1 LOCATION OF WATER WELL: Fraction NW 1/4 NW 1/4 SE 1/4 Section Number 17 Township Number T 13 S Range Number R 22 EW  
County: JOHNSON

Distance and direction from nearest town or city street address of well if located within city?

2 WATER WELL OWNER: U.S. GOVERNMENT  
RR#, St. Address, Box #: SUNFLOWER ARMY AMMUNITION PLANT Board of Agriculture, Division of Water Resources  
City, State, ZIP Code: DESOTO, KANSAS Application Number:

3 LOCATE WELL'S LOCATION WITH AN "X" IN SECTION BOX: 4 DEPTH OF COMPLETED WELL: 26.0 ft. ELEVATION: 827.34' (top of concrete pad)

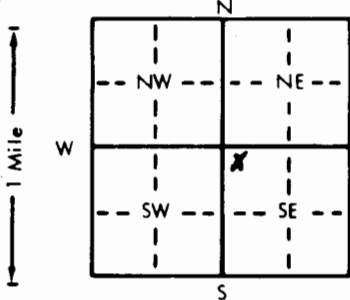

Depth(s) Groundwater Encountered 1.4 ft. 2. ft. 3. ft.  
WELL'S STATIC WATER LEVEL 1.4 ft. below land surface measured on mo/day/yr Nov 24, 1981  
Pump test data: Well water was ft. after hours pumping gpm  
Est. Yield gpm: Well water was ft. after hours pumping gpm  
Bore Hole Diameter 9 in. to 6.6 ft., and 7 7/8 in. to 36.0 ft.  
WELL WATER TO BE USED AS: 5 Public water supply 8 Air conditioning 11 Injection well  
1 Domestic 3 Feedlot 6 Oil field water supply 9 Dewatering 12 Other (Specify below)  
2 Irrigation 4 Industrial 7 Lawn and garden only 10 Observation well MONITORING WELL  
Was a chemical/bacteriological sample submitted to Department? Yes No X; If yes, mo/day/yr sample was submitted  
Water Well Disinfected? Yes No

5 TYPE OF BLANK CASING USED: 1 Steel 3 RMP (SR) 5 Wrought iron 8 Concrete tile CASING JOINTS: Glued X Clamped  
2 PVC 4 ABS 6 Asbestos-Cement 9 Other (specify below) Welded  
Blank casing diameter 4 in. to 3.5 ft., Dia. in. to ft., Dia. in. to ft.  
Casing height above land surface 11.8 in. weight lbs./ft. Wall thickness or gauge No. SCHEDULE 40  
TYPE OF SCREEN OR PERFORATION MATERIAL: 2.83 Ft 7 PVC 10 Asbestos-cement  
1 Steel 3 Stainless steel 5 Fiberglass 8 RMP (SR) 11 Other (specify)  
2 Brass 4 Galvanized steel 6 Concrete tile 9 ABS 12 None used (open hole)

SCREEN OR PERFORATION OPENINGS ARE: 5 Gauzed wrapped 8 Saw cut 11 None (open hole)  
1 Continuous slot 3 Mill slot 6 Wire wrapped 9 Drilled holes  
2 Louvered shutter 4 Key punched 7 Torch cut 10 Other (specify)

SCREEN-PERFORATED INTERVALS: From 3.5 ft. to 33.5 ft., From ft. to ft.  
From ft. to ft., From ft. to ft.  
GRAVEL PACK INTERVALS: From 2.5 ft. to 36.0 ft., From ft. to ft.  
From ft. to ft., From ft. to ft.

6 GROUT MATERIAL: 1 Neat cement 2 Cement grout 3 Bentonite 4 Other NEAT CEMENT w/4% BENTONITE  
Grout Intervals: From 0.0 ft. to 1.5 ft., From ft. to ft., From ft. to ft.  
What is the nearest source of possible contamination: 10 Livestock pens 14 Abandoned water well  
1 Septic tank 4 Lateral lines 7 Pit privy 11 Fuel storage 15 Oil well/Gas well  
2 Sewer lines 5 Cess pool 8 Sewage lagoon 12 Fertilizer storage 16 Other (specify below)  
3 Watertight sewer lines 6 Seepage pit 9 Feedyard 13 Insecticide storage

Direction from well? How many feet?

FROM TO LITHOLOGIC LOG FROM TO LITHOLOGIC LOG  
0 4.0 CLAYS (FILL)  
4.0 29.0 FARLEY LS. MBR., WYANDOTTE FM.  
29.0 30.2 ISLAND CREEK SH. MBR., WYAN. FM.  
30.2 36.0 ARGENTINE LS. MAR., WYANDOTTE FM.

7 CONTRACTOR'S OR LANDOWNER'S CERTIFICATION: This water well was (1) constructed, (2) reconstructed, or (3) plugged under my jurisdiction and was completed on (mo/day/year) Oct 3, 1981 and this record is true to the best of my knowledge and belief. Kansas  
Water Well Contractor's License No. N/A This Water Well Record was completed on (mo/day/yr) Dec 18, 1981  
under the business name of U.S. ARMY CORPS OF ENGINEERS by (signature) John E. Mayhew  
INSTRUCTIONS: Use typewriter or ball point pen, PLEASE PRESS FIRMLY and PRINT clearly. Please fill in blanks, underline or circle the correct answers. Send top three copies to Kansas Department of Health and Environment, Division of Environment, Environmental Geology Section, Topeka, KS 66620. Send one to WATER WELL OWNER and retain one for your records.