WATER WELL PLUGGING RECORD Form WWC-5P KSA 82a-1212 ID NO. FTW-2

1 LOCATION OF WATER WELL:	Fraction	Section Number	Township Number	Range Number
County: Johnson	NW¼ SW¼ SE¼	8	13S	22E E/W

Distance and direction from nearest town or city street address of well if located within city?
5000 ft south of 35400 W 103rd St. De Soto, KS

2 WATER WELL OWNER: Sunflower Redevelopment, LLC
RR #, St. Address, Box #: 7991 Shaffer PKWY.
City, State, ZIP Code : Littleton, CO 80127
Board of Agriculture, Division of Water Resources Application Number:

3 MARK WELL'S LOCATION WITH AN "X" IN SECTION BOX:

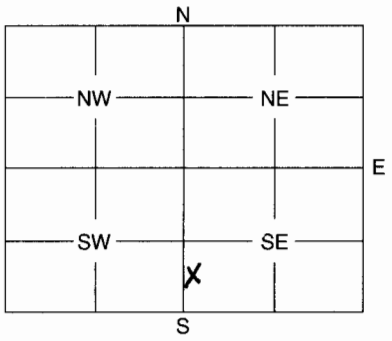

4 DEPTH OF WELL 8 ft.
WELL'S STATIC WATER LEVEL NA ft.

WELL WAS USED AS:

(1) Domestic	5 Public Water Supply	9 Dewatering
2 Irrigation	6 Oil Field Water Supply	10 Monitoring Well
3 Feedlot	7 Domestic (Lawn & Garden)	11 Injection Well
4 Industrial	8 Air Conditioning	(12) Other Fluorescent Tube Disposal

Was a chemical / bacteriological sample submitted to Department? Yes ..... No ..... not Known
If yes, mo/day/yr sample was submitted .....

Water Well Disinfected: Yes ..... No ..... not Known

5 TYPE OF BLANK CASING USED:

1 Steel	3 RMP (SR)	5 Wrought	7 Fiberglass	(9) Other (Specify below) Rock-Lined
2 PVC	4 ABS	6 Asbestos-Cement	8 Concrete Tile	

Blank casing diameter 6 ft in. Was casing pulled? (Yes) No If yes, how much Entire well removed
Casing height above or below land surface ..... in.

6 GROUT PLUG MATERIAL: 1 Neat cement 2 Cement grout 3 Bentonite (4) Other concrete

Grout Plug Intervals: From 2.5 ft. to 3 ft., From ..... ft. to ..... ft., From ..... to ..... ft.

What is the nearest source of possible contamination:

1 Septic tank	6 Seepage pit	11 Fuel storage	(16) Other (specify below) Fluorescent tubes and debris were removed prior to plugging.
2 Sewer lines	7 Pit privy	12 Fertilizer storage	
3 Watertight sewer lines	8 Sewage lagoon	13 Insecticide storage	
4 Lateral lines	9 Feedyard	14 Abandoned water well	
5 Cess pool	10 Livestock pens	15 Oil well/Gas well	

Direction from well? in well How many feet? N/A

FROM	TO	PLUGGING MATERIALS
0	2.5	clay
2.5	3	concrete
3	9	clay
9	11	gravel

Plugging information compiled from SFAAP records
I was not present. This information retrieved from files.

7 CONTRACTOR'S OR LANDOWNER'S CERTIFICATION: This water well was plugged under my jurisdiction and was completed on (mo/day/year) between 9/1/97 and 10/31/97 and this record is true to the best of my knowledge and belief. Kansas Water Well Contractor's License No. ..... This Water Well Record was completed on (mo/day/year) 04/23/09 under the business name of Army by (signature) Tony E. Spraw

INSTRUCTIONS: Use typewriter or ball point pen. Please press firmly and print clearly. Please fill in blanks, underline or circle the correct answers. Send top three copies to Kansas Department of Health and Environment, Bureau of Water, Geology Section, 1000 SW Jackson St., Ste. 420, Topeka, Kansas 66612-1367. Telephone: 785/296-5522. Send one to Water Well Owner and retain one for your records.