

WATER WELL RECORD Form WWC-5

Division of Water Resources App. No.


069MW001

Original Record Correction Change in Well Use

Well ID

1 LOCATION OF WATER WELL: County: Johnson Fraction 1/4 SE 1/4 NE 1/4 SE 1/4 Section Number 8 Township Number T 13 S Range Number R 22 E W

2 WELL OWNER: Last Name: First: Street or Rural Address where well is located: Sunflower Army Ammunition Plant 35425 W. 103rd Street South Spoon Creek Road Sunflower AAP, DeSoto, KS 66018

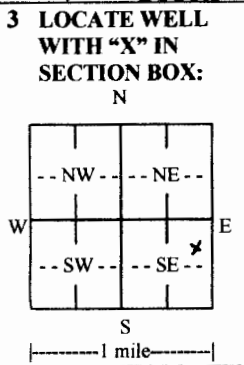

4 DEPTH OF COMPLETED WELL: 12.70 ft. Depth(s) Groundwater Encountered: 1) 10.60 ft. 2) N/A ft. 3) N/A ft. or 4) Dry Well WELL'S STATIC WATER LEVEL: 10.20 ft. below land surface, measured on (mo-day-yr) 10-10-17

5 Latitude: 38.9313087 Longitude: -94.9847895 Horizontal Datum: WGS 84 NAD 83 NAD 27 Source for Latitude/Longitude: GPS (unit make/model: Trimble Model R8)

6 Elevation: 809.412 ft. Ground Level Topographic Map Other

7 WELL WATER TO BE USED AS: 1. Domestic 2. Irrigation 3. Feedlot 4. Industrial 5. Public Water Supply 6. Dewatering 7. Aquifer Recharge 8. Monitoring 9. Environmental Remediation 10. Oil Field Water Supply 11. Test Hole 12. Geothermal 13. Other

Was a chemical/bacteriological sample submitted to KDHE? Water well disinfected?

8 TYPE OF CASING USED: Steel PVC Other CASING JOINTS: Glued Clamped Welded Threaded Casing diameter 2 in. to 7.70 ft. Diameter N/A in. to N/A ft. Diameter N/A in. to N/A ft. Casing height above land surface 30 in. Weight lbs./ft. Wall thickness or gauge No. Sched 40

TYPE OF SCREEN OR PERFORATION MATERIAL: Steel Stainless Steel Fiberglass PVC Other (Specify)

SCREEN OR PERFORATION OPENINGS ARE: Continuous Slot Mill Slot Gauze Wrapped Torch Cut Drilled Holes Other (Specify) Louvered Shutter Key Punched Wire Wrapped Saw Cut None (Open Hole)

SCREEN-PERFORATED INTERVALS: From 7.70 ft. to 12.70 ft. GRAVEL PACK INTERVALS: From 4.70 ft. to 12.70 ft.

9 GROUT MATERIAL: Neat cement Cement grout Bentonite Other Concrete 0 to 2 feet Grout Intervals: From 2 ft. to 4.70 ft. From ft. to ft. From ft. to ft.

Nearest source of possible contamination: Septic Tank Lateral Lines Pit Privy Livestock Pens Insecticide Storage Sewer Lines Cess Pool Sewage Lagoon Fuel Storage Abandoned Water Well Watertight Sewer Lines Seepage Pit Feedyard Fertilizer Storage Oil Well/Gas Well Other (Specify) Disposal Area Southeast Distance from well? 122 ft.

Table with columns: 10 FROM TO LITHOLOGIC LOG FROM TO LITHO. LOG (cont.) or PLUGGING INTERVALS. Row 1: 0' 12.7' Clay, with silt

11 CONTRACTOR'S OR LANDOWNER'S CERTIFICATION: This water well was constructed, reconstructed, or plugged under my jurisdiction and was completed on (mo-day-year) 10-10-17 and this record is true to the best of my knowledge and belief. Kansas Water Well Contractor's License No. 759 This Water Well Record was completed on (mo-day-year) 11-5-17 under the business name of RAZEK Environmental, LLC Signature