

# WATER WELL PLUGGING RECORD Form WWC-5P

KSA 82a-1212

ID NO.

060MW002

<b>1 LOCATION OF WATER WELL:</b> County: Johnson County	Fraction <u>1 KGS-022</u> <u>NW 1/4 SE 1/4 NE 1/4 NW 1/4</u>	Section Number <u>8</u>	Township Number <u>13 T S</u>	Range Number <u>22</u> <input checked="" type="checkbox"/> E <input type="checkbox"/> W
--	---	----------------------------	----------------------------------	--

Street/Rural Address of Well Location; if unknown, distance & direction from nearest town or intersection: If at owner's address, check here ☐

Sunflower Redevelopment, LLC  
105345W, 103rd Street,  
De Soto, Kansas 66019

## Global Positioning Systems (GPS) information:

Latitude: 38.9402395 (in decimal degrees)

Longitude: -094.9945132 (in decimal degrees)

Elevation: \_\_\_\_\_

Datum: ☒ WGS84, ☐ NAD83, ☐ NAD27

Collection Method:


☐ GPS unit (Make/Model: \_\_\_\_\_)

☐ Digital Map/Photo, ☐ Topographic Map, ☐ Land Survey

Est. Accuracy: ☐ < 3 m, ☐ 3-5 m, ☐ 5-15 m, ☐ > 15 m

**2 WATER WELL OWNER:** US Army Corp of Engineers - KCD  
RR#, St. Address, Box #: 635 Federal Building  
City, State ZIP Code: 601 East 12th Street  
Kansas City, MO 61406

## 3 MARK WELL'S LOCATION WITH AN "X" IN SECTION BOX:

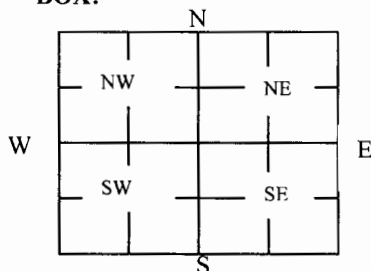

## 4 DEPTH OF WELL 8.0 ft.

WELL'S STATIC WATER LEVEL \_\_\_\_\_ ft

WELL WAS USED AS:

☐ Domestic  
☐ Irrigation  
☐ Feedlot  
☐ Industrial

☐ Public Water Supply  
☐ Oil Field Water Supply  
☐ Domestic (Lawn & Garden)  
☐ Air Conditioning

☐ Dewatering  
☒ Monitoring  
☐ Injection Well  
☐ Other \_\_\_\_\_

Was a chemical/bacteriological sample submitted to Department? Yes ☐ No ☒

## 5 TYPE OF BLANK CASING USED:

☐ Steel  
☒ PVC

☐ RMP (SR)  
☐ ABS

☐ Wrought  
☐ Asbestos-Cement

☐ Fiberglass  
☐ Concrete Tile

☐ Other (Specify below) \_\_\_\_\_

Blank casing diameter 1.5 in. Was casing pulled? Yes ☐ No ☒

Casing height above or below land surface \_\_\_\_\_ in.

If yes, how much \_\_\_\_\_  
Entire well removed by excavation, approval granted by KDHE.

## 6 GROUT PLUG MATERIAL:

☐ Neat cement

☐ Cement grout

☐ Bentonite

☒ Other

Entire well removed by excavation, approval granted by KDHE.

Grout Plug Intervals: From \_\_\_\_\_ ft. to \_\_\_\_\_ ft., From \_\_\_\_\_ ft. to \_\_\_\_\_ ft., From \_\_\_\_\_ to \_\_\_\_\_ ft.

What is the nearest source of possible contamination:

☐ Septic tank  
☐ Sewer lines  
☐ Watertight sewer lines  
☐ Lateral lines  
☐ Cess pool

☐ Seepage pit  
☐ Pit privy  
☐ Sewage lagoon  
☐ Feedyard  
☐ Livestock pens

☐ Fuel Storage  
☐ Fertilizer storage  
☐ Insecticide storage  
☐ Abandoned water well  
☐ Oil well/Gas well

☐ Other (specify below) \_\_\_\_\_

Direction from well? \_\_\_\_\_  
How many feet? \_\_\_\_\_

FROM	TO	PLUGGING MATERIALS	FROM	TO	PLUGGING MATERIALS
0	8.0	Entire well removed by excavation, approval granted by KDHE.			

**7 CONTRACTOR'S OR LANDOWNER'S CERTIFICATION:** This water well was plugged under my jurisdiction and was completed on (mo/day/year) 10/1/2022 and this record is true to the best of my knowledge and belief. Kansas Water Well Contractor's License No. NA. This Water Well Record was completed on (mo/day/year) 10/28/2022 under the business name of Burns & McDonnell Engineering Company, Inc by (signature) Timothy J. Stedman

**INSTRUCTIONS:** Use typewriter or ballpoint pen. Please press firmly and print clearly. Please fill in blanks, underline or circle the correct answers. Send top three copies to Kansas Department of Health and Environment, Bureau of Water, Geology Section, 1000 SW Jackson St., Ste. 420, Topeka, Kansas 66612-1367. Telephone: 785/296-5524. Send one to Water Well Owner and retain one for your records. Visit us at <http://www.kdheks.gov/waterwell/index.html>.

Check one: ☐ White Copy ☐ Blue Copy ☐ Pink Copy