

USE TYPEWRITER OR BALLPOINT PEN - PRESS FIRMLY, PRINT CLEARLY.

WATER WELL RECORD
KSA 82a-1201-1215

Kansas Department of Health and Environment - Division of Environment
(Water well Contractors)
Topeka, Kansas 66620

DBA

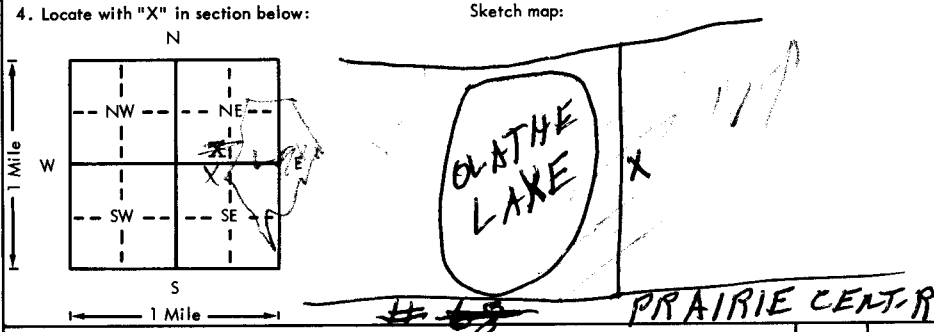
13

RECEIVED
MAY 10 1978
DIVISION OF ENVIRONMENT
STATE OF KANSAS

1. Location of well: Johnson
 Fraction: NE NW SE
 SE 1/4 SW 1/4 NE 1/4
 Section number: 32
 Township number: T 13S
 Range number: R 23 E E/W

2. Distance and direction from nearest town or city: 30 WEST OF CITY LIMITS OF OLATHE
 Street address of well location if in city: OLATHE

3. Owner of well: E.F. Thorpe, Jr.
 R.R. or street: R.R. 3 Bx. 44
 City, state, zip code: Olathe, Ks.. 66061

4. Locate with "X" in section below: Sketch map:


5. Type and color of material

	From	To
surface	0	1
broken lime	1	5
lime	5	12
shale grey	12	14
shale red	14	16
shale grey	16	25
sandstone grey	25	27
shale sandy, grey	27	35
limestone yellow top, grey	35	45
shale grey	45	46
limestone yellowish	46	100
shale grey	100	102
limestone	102	105
shale dark grey	105	146
lime	146	T.D
DRY HOLE---PLUGGED		

6. Bore hole dia. _____ in. Completion date _____
 Well depth _____ ft.

7. Cable tool _____ Rotary _____ Driven _____ Dug _____
 Hollow rod _____ Jetted _____ Bored _____ Reverse rotary _____

8. Use: Domestic _____ Public supply _____ Industry _____
 Irrigation _____ Air conditioning _____ Stock _____
 Lawn _____ Oil field water _____ Other _____

9. Casing: Material _____ Height: Above or below _____
 Threaded _____ Welded _____ Surface _____ in.
 RMP _____ PVC _____ Weight _____ lbs./ft.
 Dia. _____ in. to _____ ft. depth Wall Thickness: inches or _____
 Dia. _____ in. to _____ ft. depth gage No. _____

10. Screen: Manufacturer's name _____
 DRY HOLE
 Type _____ Dia. _____
 Slot/gauze _____ Length _____
 Set between _____ ft. and _____ ft.
 _____ ft. and _____ ft.
 Gravel pack? _____ Size range of material _____

11. Static water level _____ mo./day/yr.
 DRY HOLE
 ft. below land surface Date _____

12. Pumping level below land surfaces:
 ft. after _____ hrs. pumping _____ g.p.m.
 DRY HOLE
 ft. after _____ hrs. pumping _____ g.p.m.
 Estimated maximum yield _____ g.p.m.

13. Water supply substituted: _____ mo./day/yr.
 DRY HOLE
 Yes _____ No _____ Date _____

14. Well head completion: _____
 Pitless adapter _____ Inches above grade

15. Well grouted? _____
 With: _____ Neoprene _____ Bentonite _____ Concrete _____
 Depth: From _____ ft. to _____ ft.

16. Nearest source of possible contamination:
 ft. _____ Type _____
 Well disinfected upon completion? _____ Yes _____ No

17. Pump: _____ Not installed
 DRY HOLE
 Manufacturer's name _____
 Model number _____ HP _____ Volts _____
 Length of drop pipe _____ ft. capacity _____ g.p.m.
 Type:
 _____ Submersible _____ Turbine
 _____ Jet _____ Reciprocating
 _____ Centrifugal _____ Other

18. Elevation: 1090
 Topography: X Hill
 _____ Slope
 _____ Upland
 _____ Valley

19. Remarks: 1008 (FROM map)

20. Water well contractor's certification:
 This well was drilled under my jurisdiction and this report is true to the best of my knowledge and belief.
 F.E. Young Drilling Co. 240
 Business name License No.
 Address 6355 Robinhood Ln.
 Signed F. Young Date 10/16
 Authorized representative

(Use a second sheet if needed)

Forward the white, blue and pink copies to the Department of Health and Environment

Form WWC-5

BR=1009

L 3 2 3 W 3 2 Sec 1/4 1/4 1/4