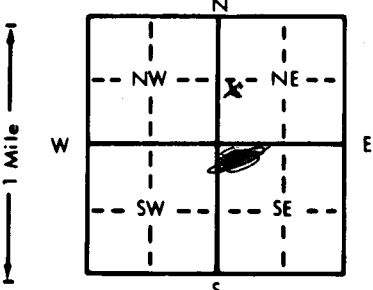


KSA 82a-1212					
1 LOCATION OF WATER WELL:		Fraction	Section Number	Township Number	Range Number
County: <u>Johnson</u>		<u>NW 1/4 SW 1/4 NE 1/4</u>	<u>36</u>	<u>T 13 S</u>	<u>R 23 E</u>
Distance and direction from nearest town or city street address of well if located within city? <u>20 feet east of west fence, 8 feet North of North fence, Northwest area of chemical commodities yard,</u>					
2 WATER WELL OWNER:		300-320 South 8th Street <u>Olathe, KS</u>			
RR#, St. Address, Box #:		Board of Agriculture, Division of Water Resources			
City, State, ZIP Code		Application Number:			
<u>Topeka, KS 66620</u>					
3 LOCATE WELL'S LOCATION WITH AN "X" IN SECTION BOX:		4 DEPTH OF COMPLETED WELL: <u>18.5</u> ft. ELEVATION:			
		Depth(s) Groundwater Encountered 1. ft. 2. ft. 3. ft.			
		WELL'S STATIC WATER LEVEL: ft. below land surface measured on mo/day/yr			
		Pump test data: Well water was ft. after hours pumping gpm			
		Est. Yield gpm: Well water was ft. after hours pumping gpm			
		Bore Hole Diameter: <u>6</u> in. to <u>18.5</u> ft., and in. to ft.			
		WELL WATER TO BE USED AS:			
		5 Public water supply 8 Air conditioning 11 Injection well			
		1 Domestic 3 Feedlot 6 Oil field water supply 9 Dewatering 12 Other (Specify below)			
		2 Irrigation 4 Industrial 7 Lawn and garden only <u>10 Observation well</u> <u>Monitoring well</u>			
		Was a chemical/bacteriological sample submitted to Department? Yes ☒ No ☐ If yes, mo/day/yr sample was submitted <u>1/6/89</u>			
		Water Well Disinfected? Yes ☐ No ☒			
5 TYPE OF BLANK CASING USED:					
1 Steel 3 RMP (SR) 5 Wrought iron 8 Concrete tile CASING JOINTS: Glued Clamped					
<u>2 PVC</u> 4 ABS 7 Fiberglass 9 Other (specify below) <u>Welded</u>					
<u>Threaded</u>					
Blank casing diameter <u>2</u> in. to <u>18.5</u> ft., Dia in. to ft.					
Casing height above land surface <u>1.02</u> ft. weight lbs./ft. Wall thickness or gauge No. <u>Sch. 40</u>					
TYPE OF SCREEN OR PERFORATION MATERIAL:					
1 Steel 3 Stainless steel 5 Fiberglass 8 RMP (SR) 10 Asbestos-cement					
2 Brass 4 Galvanized steel 6 Concrete tile 9 ABS 11 Other (specify)					
12 None used (open hole)					
SCREEN OR PERFORATION OPENINGS ARE:					
1 Continuous slot 3 <u>Mill slot</u> 5 Gauzed wrapped 8 Saw cut 11 None (open hole)					
2 Louvered shutter 4 Key punched 6 Wire wrapped 9 Drilled holes					
7 Torch cut 10 Other (specify)					
SCREEN-PERFORATED INTERVALS: From <u>13.5</u> ft. to <u>18.5</u> ft., From ft. to ft.					
GRAVEL PACK INTERVALS: From <u>3.5</u> ft. to <u>18.5</u> ft., From ft. to ft.					
6 GROUT MATERIAL:					
1 Neat cement 2 <u>Cement grout</u> 3 <u>Bentonite</u> 4 Other					
Grout intervals: From <u>0</u> ft. to <u>2.5</u> ft., From <u>2.5</u> ft. to <u>3.5</u> ft., From ft. to ft.					
What is the nearest source of possible contamination:					
1 Septic tank 4 Lateral lines 7 Pit privy 10 Livestock pens 14 Abandoned water well					
2 Sewer lines 5 Cess pool 8 Sewage lagoon 11 Fuel storage 15 Oil well/Gas well					
3 Watertight sewer lines 6 Seepage pit 9 Feedyard 12 Fertilizer storage 16 Other (specify below)					
<u>Chemical storage plant</u>					
Direction from well? <u>South</u>					
How many feet?					
FROM TO LITHOLOGIC LOG FROM TO LITHOLOGIC LOG					
<u>0.0</u> <u>1.8</u> <u>Soil, dark gray to black</u>					
<u>1.8</u> <u>5.0</u> <u>clay, light brown, damp, silty</u>					
<u>5.0</u> <u>10.0</u> <u>clay, silty, light brown, moist, with chemical odor.</u>					
<u>10.0</u> <u>13.0</u> <u>shale, badly weathered, tan to greenish color, very moist, some chemical odor,</u>					
<u>13.0</u> <u>17.0</u> <u>shale, tan to greenish color, moist</u>					
<u>17.0</u> <u>18.5</u> <u>shale, green, clayey, damp</u>					
<u>18.5</u> <u>stopped in sand - T.O.</u>					
7 CONTRACTOR'S OR LANDOWNER'S CERTIFICATION: This water well was <u>(1)</u> constructed, (2) reconstructed, or (3) plugged under my jurisdiction and was completed on (mo/day/year) <u>1/21/89</u> and this record is true to the best of my knowledge and belief. Kansas Water Well Contractor's License No. This Water Well Record was completed on (mo/day/yr) <u>1/21/89</u> under the business name of <u>Kansas Dept of Health & Environment</u> by (signature) <u>Mani W. Hefter</u>					
INSTRUCTIONS: Use typewriter or ball point pen. PLEASE PRESS FIRMLY and PRINT clearly. Please fill in blanks, underline or circle the correct answers. Send top three copies to Kansas Department of Health and Environment, Bureau of Water Protection, Topeka, Kansas 66620-7320, Telephone: 913-862-9360. Send one to WATER WELL OWNER and retain one for your records.					