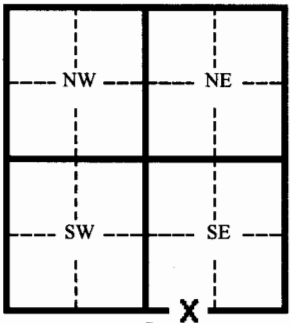


1 LOCATION OF WATER WELL:	Fraction	Section Number	Township Number	Range Number
County: Johnson	SE ¼ SW ¼ SE ¼	25	13	23-East

Distance and direction from nearest town or city street address of well if located within city?

830 E. Santa Fe, Olathe, Kansas

2 WATER WELL OWNER: Glenda Berg	Board of Agriculture, Division of Water Resources Application Number:
RR#, St. Address, Box # 10332 Cody	
City, State, ZIP Code : Overland Park, Kansas 66214	

3 MARK WELL'S LOCATON WITH AN "X" IN SECTION BOX:	4 DEPTH OF WELL 12.5 ft.												
	WELL'S STATIC WATER LEVEL 5.49 ft.												
	WELL WAS USED AS:												
	<table><tr><td>1 Domestic</td><td>5 Public Water Supply</td><td>9 Dewatering</td></tr><tr><td>2 Irrigation</td><td>6 Oil Field Water Supply</td><td>10 Monitoring Well</td></tr><tr><td>3 Feedlot</td><td>7 Lawn and Garden (domestic)</td><td>11 Injection Well</td></tr><tr><td>4 Industrial</td><td>8 Air Conditioning</td><td>12 Other</td></tr>
Was a chemical/bacteriological sample submitted to Department? Yes _____ No X													


If yes, mo/day/yr sample was submitted _____

Water Well Disinfected: Yes _____ No **X**

5 TYPE OF BLANK CASING USED:	1 Steel	3 RMP (SR)	5 Wrought	7 Fiberglass	9 Other (specify below)
2 PVC	4 ABC	6 Asbestos-Cement	8 Concrete Tile		
Blank casing diameter 2.375 in.	Was casing pulled? Yes X No _____	If yes, how much? 12.5'			
Casing height above or below land surface Unknown in.	Overdrilled well to 12.5'				

6 GROUT PLUG MATERIAL:	1 Neat cement	2 Cement grout	3 Bentonite	4 Other	Soils
Grout Plug Intervals From 12.5 ft. to 3.0 ft. From 3.0 ft. to 0.0 ft. From _____ ft. to _____ ft.					
What is the nearest source of possible contamination:					
1 Septic tank	6 Seepage pit	11 Fuel storage (former)	16 Other (specify below)		
2 Sewer lines	7 Pit privy	12 Fertilizer storage			
3 Watertight sewer lines	8 Sewage lagoon	13 Insecticide storage			
4 Lateral lines	9 Feedyard	14 Abandoned water well			
5 Cess Pool	10 Livestock pens	15 Oil well/ Gas well			
Direction from well? North	How many feet? 50				

FROM	TO	CODE	PLUGGING MATERIALS
0.0	3.0		Compacted soils
3.0	12.5		Bentonite chips

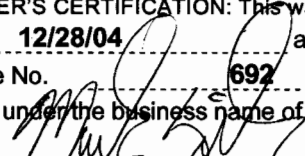7 CONTRACTOR'S OR LANDOWNER'S CERTIFICATION: This water well was plugged under my jurisdiction and was completed on (mo/day/yr) 12/28/04 and this record is true to the best of my knowledge and belief. Kansas Water Well Contractor's License No. 692 This Water Well Record was completed on (mo/day/yr) 12/30/04 under the business name of Quad State Services, Inc.
by (signature) 

INSTRUCTIONS: Please fill in blanks and circle the correct answers. Send three copies to Kansas Department of Health and Environment, Bureau of Water, 1000 S W Jackson St., Ste. 420, Topeka, Kansas 66620-0001. Telephone: 785-296-3565. Send one to Water Well Owner and retain one for your records.