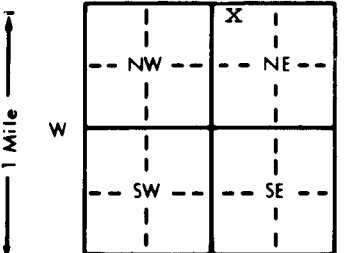


1 LOCATION OF WATER WELL: County: JOHNSON		Fraction NW 1/4 NW 1/4 NE 1/4	Section Number 36	Township Number T 13 S	Range Number R 23
Distance and direction from nearest town or city street address of well if located within city? 901 EAST SANTA FE OLATHE, KS				MW#3	
2 WATER WELL OWNER: COASTAL MART, INC. C/O DEBBIE HARRIS 9 GREENWAY PLAZA SUITE# 2810 HOUSTON, TX. 77046				Board of Agriculture, Division of Water Resources Application Number:	
3 LOCATE WELL'S LOCATION WITH AN "X" IN SECTION BOX:		4 DEPTH OF COMPLETED WELL: 12.5 ft. ELEVATION:			
		Depth(s) Groundwater Encountered 1. ft. 2. ft. 3. ft. WELL'S STATIC WATER LEVEL ft. below land surface measured on mo/day/yr Pump test data: Well water was ft. after hours pumping gpm Est. Yield gpm: Well water was ft. after hours pumping gpm Bore Hole Diameter 7 1/4 in. to 12.5 ft. and in. to ft. WELL WATER TO BE USED AS: 1 Domestic 3 Feedlot 6 Oil field water supply 9 Dewatering 12 Other (Specify below) 2 Irrigation 4 Industrial 7 Lawn and garden only 10 Monitoring well Was a chemical/bacteriological sample submitted to Department? Yes No; If yes, mo/day/yr sample was submitted Water Well Disinfected? Yes No			
5 TYPE OF BLANK CASING USED: 1 Steel 3 RMP (SR) X 2 PVC 4 ABS		5 Wrought iron 8 Concrete tile CASING JOINTS: Glued Clamped 6 Asbestos-Cement 9 Other (specify below) Welded 7 Fiberglass Threaded. X			
Blank casing diameter 2 in. to 5 ft. Dia in. to ft. Dia in. to ft. Casing height above land surface 0 in. weight sched 40 lbs./ft. Wall thickness or gauge No.					
TYPE OF SCREEN OR PERFORATION MATERIAL: 1 Steel 3 Stainless steel 5 Fiberglass 8 RMP (SR) 2 Brass 4 Galvanized steel 6 Concrete tile 9 ABS 12 None used (open hole)		X7 PVC 10 Asbestos-cement 11 Other (specify)			
SCREEN OR PERFORATION OPENINGS ARE: 1 Continuous slot X3 Mill slot 0.10 2 Louvered shutter 4 Key punched 12.5 SCREEN-PERFORATED INTERVALS: From ft. to ft. From ft. to ft. From ft. to ft. From ft. to ft.		5 Gauzed wrapped 8 Saw cut 11 None (open hole) 6 Wire wrapped 9 Drilled holes 7 Torch cut 10 Other (specify)			
GRAVEL PACK INTERVALS: From ft. to ft. From ft. to ft. From ft. to ft. From ft. to ft.					
6 GROUT MATERIAL: 2.5 Neat cement - .03 Cement grout 4 X3 Bentonite 2.5 4 Other		Grout Intervals: From ft. to ft. From ft. to ft. From ft. to ft. From ft. to ft.			
What is the nearest source of possible contamination: 1 Septic tank 4 Lateral lines 7 Pit privy 10 Livestock pens 14 Abandoned water well 2 Sewer lines 5 Cess pool 8 Sewage lagoon 11 Fuel storage 15 Oil well/Gas well X 3 Watertight sewer lines 6 Seepage pit 9 Feedyard 12 Fertilizer storage 16 Other (specify below) 13 Insecticide storage		Direction from well? east How many feet? 15			
FROM TO LITHOLOGIC LOG		FROM TO		PLUGGING INTERVALS	
0	6"	CONCRETE			
6"	2	BASE ROCK			
2	8	BRN SILTY CLAY			
8	11.5	BRN TAN MOIST CLAY			
11.5	12.5	LIMESTONE			
7 CONTRACTOR'S OR LANDOWNER'S CERTIFICATION: This water well was (X) constructed, (2) reconstructed, or (3) plugged under my jurisdiction and was completed on (mo/day/year) 2-3-98 and this record is true to the best of my knowledge and belief. Kansas Water Well Contractor's License No. 575 This Water Well Record was completed on (mo/day/year) 2-16-98 under the business name of KURTZ ENVIRONMENTAL SERVICE by (signature)					
INSTRUCTIONS: Use typewriter or ball point pen. PLEASE PRESS FIRMLY and PRINT clearly. Please fill in blanks, underline or circle the correct answers. Send top three copies to Kansas Department of Health and Environment, Bureau of Water, Topeka, Kansas 66620-0001. Telephone: 913-296-5545. Send one to WATER WELL OWNER and retain one for your records.					