

CORRECTION(S) TO WATER WELL RECORD (WWC-5)

(to rectify lacking or incorrect information)

County: Johnson

Location listed as:

Section-Township-Range: 25-12 S-19 EFraction ($\frac{1}{4}$ $\frac{1}{4}$ $\frac{1}{4}$): SE NW SE

Location changed to:

25-13 S-23 ENW SE SWOther changes: Initial statements: Latitude: 973.05Longitude: 3465.19Changed to: Latitude: 38.8863470Longitude: -94.8094960Comments: Values entered in Lat/Long boxes are actually footages from SE corner of section (see second page).verification method: Well site address, legal description and footages given on second page, KGS' "LEO" conversion tool, and mapping tool & aerial photos on KGS website. initials: ERL date: 9/22/2009

submitted by: Kansas Geological Survey, Data Resources Library, 1930 Constant Ave., Lawrence, KS 66047-3726

to: Kansas Dept of Health & Environment, Bureau of Water, 1000 SW Jackson, Suite 420, Topeka, KS 66612-1367.

mw 2

00 378 543

WATER WELL PLUGGING RECORD Form WWC-5P

KSA 82a-1212

ID NO.

A4-046-40291

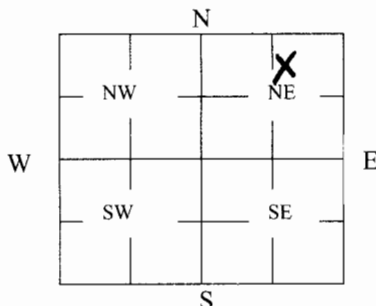
1 LOCATION OF WATER WELL: County: <u>Johnson</u>	Fraction <u>SE 1/4 NW 1/4 SE 1/4</u>	Section Number <u>25</u>	Township Number <u>12S</u>	Range Number <u>19</u> <u>EW</u>
---	---	-----------------------------	-------------------------------	-------------------------------------

Distance and direction from nearest town or city street address of well if located within city?

520 E. Kansas City Road Olathe, KS

2 WATER WELL OWNER: <u>M+M ORL CO. INC</u> RR#, St. Address, Box #: <u>Sherry McBride</u> <u>PO BOX 171</u> City, State ZIP Code: <u>Lawrence, KS 66044</u>	Global Positioning Systems (decimal degrees, min. of 4 digits) Latitude: <u>37.05</u> Longitude: <u>94.6519</u> Elevation: <u>1034.17</u> Datum: _____ Data Collection Method: <u>Survey (attached)</u>
--	--

3 MARK WELL'S LOCATION WITH AN "X" IN SECTION BOX:

4 DEPTH OF WELL 6.4 ft.WELL'S STATIC WATER LEVEL 5.51 ft

WELL WAS USED AS:

- | | | |
|--------------|----------------------------|----------------------|
| 1 Domestic | 5 Public Water Supply | 9 Dewatering |
| 2 Irrigation | 6 Oil Field Water Supply | <u>10 Monitoring</u> |
| 3 Feedlot | 7 Domestic (Lawn & Garden) | 11 Injection Well |
| 4 Industrial | 8 Air Conditioning | 12 Other _____ |

Was a chemical/bacteriological sample submitted to Department? Yes _____ No X

5 TYPE OF BLANK CASING USED:

- | | | | | |
|--------------|------------|-------------------|-----------------|-------------------------|
| 1 Steel | 3 RMP (SR) | 5 Wrought | 7 Fiberglass | 9 Other (Specify below) |
| <u>2 PVC</u> | 4 ABS | 6 Asbestos-Cement | 8 Concrete Tile | _____ |

Blank casing diameter 2 in. Was casing pulled? Yes _____ No X If yes, how much _____Casing height above or below land surface 8 in.6 GROUT PLUG MATERIAL: 1 Neat cement 2 Cement grout 3 Bentonite 4 Other _____Grout Plug Intervals: From 6.4 ft. to Surface ft., From _____ ft. to _____ ft., From _____ to _____ ft.

What is the nearest source of possible contamination:

- | | | | |
|--------------------------|-------------------|-------------------------|---------------------------------|
| 1 Septic tank | 6 Seepage pit | 11 Fuel Storage | 16 Other (specify below) |
| 2 Sewer lines | 7 Pit privy | 12 Fertilizer storage | <u>Removed UST Basin (Fuel)</u> |
| 3 Watertight sewer lines | 8 Sewage lagoon | 13 Insecticide storage | |
| 4 Lateral lines | 9 Feedyard | 14 Abandoned water well | Direction from well? <u>E</u> |
| 5 Cess pool | 10 Livestock pens | 15 Oil well/Gas well | How many feet? <u>2</u> |

FROM	TO	PLUGGING MATERIALS	FROM	TO	PLUGGING MATERIALS
<u>6.4'</u>	<u>Surface</u>	<u>BENTONITE CHIPS</u>			

7 CONTRACTOR'S OR LANDOWNER'S CERTIFICATION: This water well was plugged under my jurisdiction and was completed on (mo/day/year) 1/5/09 and this record is true to the best of my knowledge and belief. Kansas Water Well Contractor's License No. _____. This Water Well Record was completed on (mo/day/year) 1/5/09 under the business name of Tank Management Services by (signature) Charles W. Jones

INSTRUCTIONS: Use typewriter or ballpoint pen. Please press firmly and print clearly. Please fill in blanks, underline or circle the correct answers. Send top three copies to Kansas Department of Health and Environment, Bureau of Water, Geology Section, 1000 SW Jackson St., Ste. 420, Topeka, Kansas 66612-1367. Telephone: 785/296-5522. Send one to Water Well Owner and retain one for your records. Visit us at <http://www.kdheks.gov/geo/waterwells>.

ILC of TOPEKA and LAWRENCE, L.L.C.

P.O. BOX 4715
Topeka, Kansas 66604

Phone (785) 233-9954
Fax (785) 233-0059

Attn: Scott McDaniel
Tank Management
P.O.Box 678
Topeka, Kansas 66601

December 16, 2006

RE: Monitor Well Elevation Survey
520 Kansas City Road, Olathe, Kansas

Bench Mark: Square cut on SW Corner of storm inlet at SW Corner of property.
Elev.: 1029.15 North 778.91 West 3630.59 (from SE Cor. Sec. 25-13-23)

MW-1	top pipe	1033.89	North	990.02	SE1/4, NW1/4, SE1/4, SW1/4
	rim	1034.08	West	3437.85	
MW-2	top pipe	1032.66	North	973.05	SE1/4, NW1/4, SE1/4, SW1/4
	rim	1034.17	West	3465.19	
MW-3	top pipe	1031.37	North	897.01	SE1/4, NW1/4, SE1/4, SW1/4
	rim	1031.54	West	3575.48	
MW-4	top pipe	1029.58	North	844.36	SW1/4, NW1/4, SE1/4, SW1/4
	rim	1029.92	West	3661.63	
MW-5	top pipe	1031.72	North	928.25	SW1/4, NW1/4, SE1/4, SW1/4
	rim	1031.87	West	3635.05	
MW-6	top pipe	1029.15	North	749.92	SW1/4, NW1/4, SE1/4, SW1/4
	rim	1029.32	West	3673.00	
MW-7	top pipe	1029.78	North	680.80	SW1/4, NW1/4, SE1/4, SW1/4
	rim	1029.93	West	3808.00	

A recipient of the Greater Topeka Chamber of Commerce
Small Business of the Year Award for 1995

Mortgage Title Inspections • Boundary Surveys
No Start Certificates • Flood Letter Certification

