

**CORRECTION(S) TO WATER WELL RECORD (WWC-5)**  
(to rectify lacking or incorrect information)

County: Johnson

Location listed as:

Location changed to:

Section-Township-Range: 36-135-23E

36-135-23E

Fraction ( 1/4 1/4 1/4): SE NE SE NW

NW SW SW NE

Other changes: Initial statements: Jackson County

Changed to: Johnson County

Comments: \_\_\_\_\_

verification method: Latitude & Longitude, KGS' "LEO" conversion tool, written description, area road map, and mapping tool on KGS website. initials: ERL date: 7/7/2011

submitted by: Kansas Geological Survey, Data Resources Library, 1930 Constant Ave., Lawrence, KS 66047-3726  
to: Kansas Dept of Health & Environment, Bureau of Water, 1000 SW Jackson, Suite 420, Topeka, KS 66612-1367.

**WATER WELL PLUGGING RECORD Form WWC-5P**

KSA 82a-1212

ID NO.


FP-001S

**1 LOCATION OF WATER WELL:** Fraction SE 1/4 NE 1/4 SE 1/4 NW 1/4 Section Number 36 Township Number T 13 S Range Number 23  E  W  
 County: Jackson

Street/Rural Address of Well Location; if unknown, distance & direction from nearest town or intersection: If at owner's address, check here  At southeast of intersection of Cedar St and Blake Street, Olathe, KS

**Global Positioning Systems (GPS) information:**  
 Latitude: 38.878017 (in decimal degrees)  
 Longitude: -94.805685 (in decimal degrees)  
 Elevation: 1050  
 Datum:  WGS84,  NAD83,  NAD27  
 Collection Method:  
 GPS unit (Make/Model: \_\_\_\_\_)  
 Digital Map/Photo,  Topographic Map,  Land Survey  
 Est. Accuracy:  < 3 m,  3-5 m,  5-15 m,  > 15 m

**2 WATER WELL OWNER:** The Boeing Company  
 RR#, St. Address, Box #: 5800 Woolsey Canyon Rd  
 City, State ZIP Code: Canoga Park, CA 91304

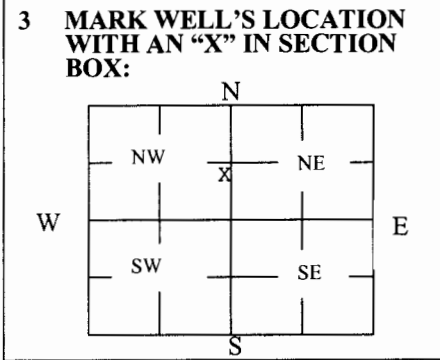

**4 DEPTH OF WELL** 7.6 ft.  
 WELL'S STATIC WATER LEVEL 3.1 ft  
 WELL WAS USED AS:  
 Domestic  Public Water Supply  Dewatering  
 Irrigation  Oil Field Water Supply  Monitoring  
 Feedlot  Domestic (Lawn & Garden)  Injection Well  
 Industrial  Air Conditioning  Other \_\_\_\_\_  
 Was a chemical/bacteriological sample submitted to Department? Yes  No

**5 TYPE OF BLANK CASING USED:**  
 Steel  RMP (SR)  Wrought  Fiberglass  Other (Specify below)  
 PVC  ABS  Asbestos-Cement  Concrete Tile  
 Blank casing diameter 1.5 in. Was casing pulled? Yes  No  If yes, how much ALL  
 Casing height above or below land surface NA in.

**6 GROUT PLUG MATERIAL:**  Neat cement  Cement grout  Bentonite  Other \_\_\_\_\_  
 Grout Plug Intervals: From 7.6 ft. to 0 ft., From \_\_\_\_\_ ft. to \_\_\_\_\_ ft., From \_\_\_\_\_ to \_\_\_\_\_ ft.

What is the nearest source of possible contamination:  
 Septic tank  Seepage pit  Fuel Storage  Other (specify below)  
 Sewer lines  Pit privy  Fertilizer storage  No known source  
 Watertight sewer lines  Sewage lagoon  Insecticide storage  
 Lateral lines  Feedyard  Abandoned water well  
 Cess pool  Livestock pens  Oil well/Gas well  
 Direction from well? \_\_\_\_\_  
 How many feet? \_\_\_\_\_

FROM	TO	PLUGGING MATERIALS	FROM	TO	PLUGGING MATERIALS
7.6	0	Hydrated Bentonite Grout			

**7 CONTRACTOR'S OR LANDOWNER'S CERTIFICATION:** This water well was plugged under my jurisdiction and was completed on (mo/day/year) 5/9/2011 and this record is true to the best of my knowledge and belief. Kansas Water Well Contractor's License No. 650. This Water Well Record was completed on (mo/day/year) 5/31/2011 under the business name of PetroCon, Inc. by (signature) *[Signature]*

**INSTRUCTIONS:** Use typewriter or ballpoint pen. Please press firmly and print clearly. Please fill in blanks, underline or circle the correct answers. Send top three copies to Kansas Department of Health and Environment, Bureau of Water, Geology Section, 1000 SW Jackson St., Ste. 420, Topeka, Kansas 66612-1367. Telephone: 785/296-5524. Send one to Water Well Owner and retain one for your records. Visit us at <http://www.kdheks.gov/waterwell/index.html>.

Check one:  White Copy  Blue Copy  Pink Copy