

WATER WELL RECORD


Form WWC-5

Division of Water Resources App. No.

1 LOCATION OF WATER WELL: County: Johnson	Fraction SW ¼ NE ¼ SW ¼ SW ¼	Section Number 7	Township No. T 13 S	Range Number R 23 <input checked="" type="checkbox"/> E <input type="checkbox"/> W
---	---------------------------------	---------------------	------------------------	---

Street/Rural Address of Well Location; if unknown, distance & direction from nearest town or intersection: If at owner's address, check here <input type="checkbox"/> 27349 W. 108th Street Olathe, Kansas 66061	Global Positioning System (GPS) information: Latitude: (in decimal degrees) Longitude: (in decimal degrees) Elevation: Datum: <input type="checkbox"/> WGS 84, <input type="checkbox"/> NAD 83, <input type="checkbox"/> NAD 27 Collection Method: <input type="checkbox"/> GPS unit (Make/Model:) <input type="checkbox"/> Digital Map/Photo, <input type="checkbox"/> Topographic Map, <input type="checkbox"/> Land Survey Est. Accuracy: <input type="checkbox"/> <3 m, <input type="checkbox"/> 3-5 m, <input type="checkbox"/> 5-15 m, <input type="checkbox"/> >15 m
---	--

2 WATER WELL OWNER: Jonathan & Jennifer Robins RR#, Street Address, Box #: 11485 S. Gleason Road City, State, ZIP Code : Olathe, Kansas 66061	
--	--

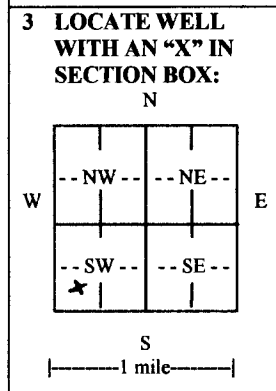

4 DEPTH OF COMPLETED WELL ^{Plugged} 400 ft. 9-400' Bores

Depth(s) Groundwater Encountered (1) None ft. (2) ft. (3) ft.

WELL'S STATIC WATER LEVEL None ft. below land surface measured on mo/day/yr.

Pump test data: Well water was ft. after hours pumping gpm

EST. YIELD None gpm. Well water was ft. after hours pumping gpm

Bore Hole Diameter 6 in. to 400 ft., and in. to ft.

WELL WATER TO BE USED AS: Public water supply Geothermal Injection well

Domestic Feedlot Oil field water supply Dewatering Other (Specify below)

Irrigation Industrial Domestic-lawn & garden Monitoring well **CLOSED LOOP**

Was a chemical/bacteriological sample submitted to Department? Yes No

If yes, mo/day/yr sample was submitted.....

Water well disinfected? Yes No

5 TYPE OF CASING USED: Steel PVC Other HD POLYETHYLENE

CASING JOINTS: Glued Clamped Welded Threaded Fusion

Casing diameter 1 in. to 400 ft., Diameter in. to ft., Diameter in. to ft.

Casing height above land surface 36 in., Weight SDR11 lbs./ft., Wall thickness or gauge No. 160 PSI

TYPE OF SCREEN OR PERFORATION MATERIAL: None

Steel Stainless Steel PVC Other (Specify)

Brass Galvanized Steel None used (open hole)

SCREEN OR PERFORATION OPENINGS ARE: None

Continuous slot Mill slot Gauze wrapped Torch cut Drilled holes None (open hole)

Louvered shutter Key punched Wire wrapped Saw cut Other (specify)

SCREEN-PERFORATED INTERVALS: From ft. to ft., From ft. to ft.

GRAVEL PACK INTERVALS: From ft. to ft., From ft. to ft.

6 GROUT MATERIAL: Neat cement Cement grout Bentonite Other

Grout Intervals: From 400 ft. to 3 ft., From 300 ft. to 250 Cement ft. to ft.

What is the nearest source of possible contamination:

Septic tank Lateral lines Pit privy Livestock pens Insecticide storage Other (specify below)

Sewer lines Cesspool Sewage lagoon Fuel storage Abandoned water well

Watertight sewer lines Seepage pit Feedyard Fertilizer storage Oil well/gas well

Direction from well North Distance from well 50'

FROM	TO	LITHOLOGIC LOG		FROM	TO	LITHO. LOG (cont.) or PLUGGING INTERVALS
0	1	SOIL/CLAY	162-175 SHALE			
1	12	LIME	175-200 LIME			
12	19	SANDSTONE	200-258 SHALE			
19	50	LIME	258-274 LIME			
50	97	SHALE	274-400 SHALE	400	3	9-400' BORES PLUGGED WITH
97	108	LIME				HIGH SOLID BENTONITE and Cement
108	128	SHALE		400	300	Bentonite
128	137	LIME		300	250	Cement
137	155	SHALE		250	0	Bentonite
155	162	LIME				

7 CONTRACTOR'S OR LANDOWNER'S CERTIFICATION: This water well was constructed, reconstructed, or plugged under my jurisdiction and was completed on (mo/day/year) 3-24-14 and this record is true to the best of my knowledge and belief. Kansas Water Well Contractor's License No. 561 This Water Well Record was completed on (mo/day/year) 3-27-14 under the business name of EVANS ENERGY DEVELOPMENT, INC. by (signature) [Signature]

INSTRUCTIONS: Use typewriter or ball point pen. PLEASE PRESS FIRMLY and PRINT clearly. Please fill in blanks and check the correct answers. Send one copy to Kansas Department of Health and Environment, Bureau of Water, Geology Section, 1000 SW Jackson St., Suite 420, Topeka, Kansas 66612-1367. Telephone 785-296-5524. Send one copy to WATER WELL OWNER and retain one for your records. Include fee of \$5.00 for each constructed well. Visit us at <http://www.kdheks.gov/waterwell/index.html>