

WATER WELL RECORD

Form WWC-5

Division of Water Resources App. No.


1 LOCATION OF WATER WELL: County: <u>Johnson</u>	Fraction <input type="checkbox"/> SE <input type="checkbox"/> EE <input type="checkbox"/> SE <input type="checkbox"/>	Section Number <u>25</u>	Township No. T <u>13</u> S	Range Number R <u>23</u> E <input type="checkbox"/> W
---	--	-----------------------------	-------------------------------	--

Street/Rural Address of Well Location; if unknown, distance & direction from nearest town or intersection; If at owner's address, check here

Dees Mini-Mart
1100 E. Santa Fe
Olathe, Ks.

Global Positioning System (GPS) information:
Latitude: 38.53.01.91 (in decimal degrees)
Longitude: 94.48.00.94 (in decimal degrees)
Elevation:
Datum: WGS 84, NAD 83, NAD 27
Collection Method:
 GPS unit (Make/Model: Google Earth)
 Digital Map/Photo, Topographic Map, Land Survey
Est. Accuracy: <3 m, 3-5 m, 5-15 m, >15 m

2 WATER WELL OWNER: Sandeep, LLC
RR#, Street Address, Box #: 15625 S. Moonlight Ed.
City, State, ZIP Code: Olathe, Ks. 66061

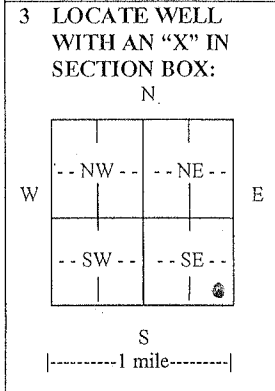

4 DEPTH OF COMPLETED WELL 17' ft.
Depth(s) Groundwater Encountered (1)..... ft. (2)..... ft. (3)..... ft.
WELL'S STATIC WATER LEVEL 13.5ft ft. below land surface measured on mo/day/yr. 4/30/14
Pump test data: Well water was.....ft. after..... hours pumping..... gpm
EST. YIELD.....gpm. Well water was.....ft. after..... hours pumping..... gpm
Bore Hole Diameter 7.5" in. to 17" ft., andin. toft.
WELL WATER TO BE USED AS: Public water supply Geothermal Injection well
 Domestic Feedlot Oil field water supply Dewatering Other (Specify below)
 Irrigation Industrial Domestic-lawn & garden Monitoring well
Was a chemical/bacteriological sample submitted to Department? Yes No
If yes, mo/day/yr sample was submitted.....
Water well disinfected? Yes No

5 TYPE OF CASING USED: Steel PVC Other
CASING JOINTS: Glued Clamped Welded Threaded
Casing diameter 2.375 in. to 4 ft., Diameter in. to ft., Diameter in. to ft.
Casing height above land surface 14.5 ft., Weight lbs./ft., Wall thickness or gauge No. sch 40
TYPE OF SCREEN OR PERFORATION MATERIAL:
 Steel Stainless Steel PVC Other (Specify)
 Brass Galvanized Steel None used (open hole)
SCREEN OR PERFORATION OPENINGS ARE:
 Continuous slot Mill slot Gauze wrapped Torch cut Drilled holes None (open hole)
 Louvered shutter Key punched Wire wrapped Saw cut Other (specify)
SCREEN-PERFORATED INTERVALS: From 17' ft. to 4' ft., From ft. to ft.
GRAVEL PACK INTERVALS: From 17' ft. to 3' ft., From ft. to ft.
From ft. to ft., From ft. to ft.

6 GROUT MATERIAL: Neat cement Cement grout Bentonite Other Concrete
Grout Intervals: From 3' ft. to 1 1/2' ft., From 1 1/2' ft. to 0' ft., From ft. to ft.
What is the nearest source of possible contamination:
 Septic tank Lateral lines Pit privy Livestock pens Insecticide storage Other (specify below)
 Sewer lines Cesspool Sewage lagoon Fuel storage Abandoned water well
 Watertight sewer lines Seepage pit Feedyard Fertilizer storage Oil well/gas well
Direction from well Northwest Distance from well 30'

FROM	TO	LITHOLOGIC LOG	FROM	TO	LITHO. LOG (cont.) or PLUGGING INTERVALS
0	1.50	Concrete			
1.50	4.50	Red clay soil			
4.50	8.50	Red mottled clay w/ iron oxides			
8.50	16.75	Yellowish brown weathered shale			
16.75	17.0	Limestone			

7 CONTRACTOR'S OR LANDOWNER'S CERTIFICATION: This water well was constructed, reconstructed, or plugged under my jurisdiction and was completed on (mo/day/year) 4/15/14 and this record is true to the best of my knowledge and belief.
Kansas Water Well Contractor's License No. 102 This Water Well Record was completed on (mo/day/year) 4/30/14
under the business name of Green Environmental Drilling (signature) James Belk

INSTRUCTIONS: Use typewriter or ball point pen. PLEASE PRESS FIRMLY and PRINT clearly. Please fill in blanks and check the correct answers. Send one copy to Kansas Department of Health and Environment, Bureau of Water, Geology Section, 1000 SW Jackson St., Suite 420, Topeka, Kansas 66612-1367. Telephone 785-296-5524. Send one copy to WATER WELL OWNER and retain one for your records. Include fee of \$5.00 for each constructed well. Visit us at