

MW4

WATER WELL RECORD


Form WWC-5

Division of Water Resources App. No.

1 LOCATION OF WATER WELL: County: Johnson Fraction: SE SE SE Section Number: 25 Township No. T 13 S Range Number R 23 E W

Street/Rural Address of Well Location: Dees Muni-Maid 1100 E. Santa Fe Olathe, Ks. Global Positioning System (GPS) information: Latitude: 38.53.01.61 Longitude: 94.48.00.94

2 WATER WELL OWNER: Sundeep LLC 15625 S. Moonlight Rd. Olathe, Ks. 66061 Collection Method: Google Earth

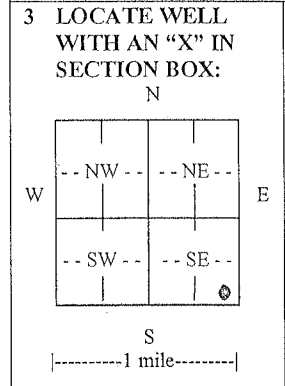

3 LOCATE WELL WITH AN 'X' IN SECTION BOX: N W E S 1 mile. 4 DEPTH OF COMPLETED WELL 17' Depth(s) Groundwater Encountered (1) 17' (2) (3) WELL'S STATIC WATER LEVEL 160' ft. below land surface measured on mo/day/yr. 4/30/14 Pump test data: Well water was ... EST. YIELD ... Bore Hole Diameter 7 1/2" in. to 17" ft., and ... WELL WATER TO BE USED AS: Monitoring well Was a chemical/bacteriological sample submitted to Department? Yes No Water well disinfected? Yes No

5 TYPE OF CASING USED: PVC Casing joints: Threaded Casing diameter 2.375 in. to 4" Diameter 4" Casing height above land surface 40" Weight ... TYPE OF SCREEN OR PERFORATION MATERIAL: PVC SCREEN OR PERFORATION OPENINGS ARE: Mill slot SCREEN-PERFORATED INTERVALS: From 17' ft. to 4' ft. GRAVEL PACK INTERVALS: From 17' ft. to 3' ft.

6 GROUT MATERIAL: Concrete Grout Intervals: From 3' ft. to 1 1/2' ft. What is the nearest source of possible contamination: Fuel storage Direction from well: North Distance from well: 25'

Table with columns: FROM, TO, LITHOLOGIC LOG, FROM, TO, LITHO. LOG (cont.) or PLUGGING INTERVALS. Rows: 0-1.50 Concrete, 1.50-4.0 DK bn - black clay, fine, 4.0-12.0 bn mottled clay, 12.0-16.5 yellowish bn weathered shale, 16.5-17.0 Limestone

7 CONTRACTOR'S OR LANDOWNER'S CERTIFICATION: This water well was constructed, reconstructed, or plugged under my jurisdiction and was completed on (mo/day/year) 4/10/14 and this record is true to the best of my knowledge and belief. Kansas Water Well Contractor's License No. 732 This Water Well Record was completed on (mo/day/year) 4/30/14 under the business name of JB Environmental Drilling by (signature) James Bieker

INSTRUCTIONS: Use typewriter or ball point pen. PLEASE PRESS FIRMLY and PRINT clearly. Please fill in blanks and check the correct answers. Send one copy to Kansas Department of Health and Environment, Bureau of Water, Geology Section, 1000 SW Jackson St., Suite 420, Topeka, Kansas 66612-1367. Telephone 785-296-5524. Send one copy to WATER WELL OWNER and retain one for your records. Include fee of \$5.00 for each constructed well. Visit us at