

MW7

WATER WELL RECORD


Form WWC-5

Division of Water Resources App. No.

1 LOCATION OF WATER WELL: County: Johnson Fraction: SE SE SE Section Number: 25 Township No. T 13 S Range Number R 23 E W

Street/Rural Address of Well Location; if unknown, distance & direction from nearest town or intersection: Wees Mini-Mart 1100 E. Santa Fe, Olathe, KS Global Positioning System (GPS) information: Latitude: 38.53.03.09 Longitude: 094.48.01.47

2 WATER WELL OWNER: Sundeeep, LLC RR#, Street Address, Box #: 15625 S. Moonlight Rd. City, State, ZIP Code: Olathe, KS. 66061 Collection Method: Google Earth

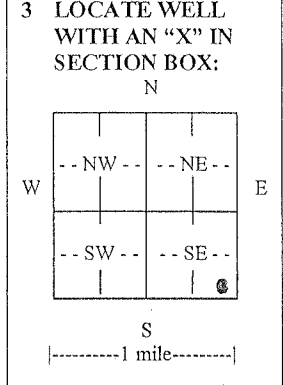

3 LOCATE WELL WITH AN 'X' IN SECTION BOX: 4 DEPTH OF COMPLETED WELL 17' Depth(s) Groundwater Encountered (1) 2.07 ft. WELL'S STATIC WATER LEVEL 2.07 ft. below land surface measured on mo/day/yr. 4/30/14

5 TYPE OF CASING USED: Steel PVC Other CASING JOINTS: Glued Clamped Welded Threaded Casing diameter 2.375 in. to 4 ft. Diameter 1 1/2 in. to 4 ft. Casing height above land surface 17 ft. Weight 110 lbs/ft. Wall thickness or gauge No. Sch 40

6 GROUT MATERIAL: Neat cement Cement grout Beatonite Other Concrete Grout Intervals: From 2' ft. to 1 1/2' ft., From 1 1/2' ft. to 0' ft. What is the nearest source of possible contamination: Fuel storage

Table with columns: FROM, TO, LITHOLOGIC LOG, FROM, TO, LITHO. LOG (cont.) or PLUGGING INTERVALS. Rows include: 0 to 5.0 DK Brn clay w/ fill, concrete, metal fill; 5.0 to 11.0 DK Brn clay w/ iron oxide; 11.0 to 16.0 yellow Brn - grey shale; 16.0 to 17.0 limestone

7 CONTRACTOR'S OR LANDOWNER'S CERTIFICATION: This water well was constructed, reconstructed, or plugged under my jurisdiction and was completed on (mo/day/year) 4/10/14 and this record is true to the best of my knowledge and belief. Kansas Water Well Contractor's License No. 732 This Water Well Record was completed on (mo/day/year) 4/30/14 under the business name of JB Environmental Drilling by (signature) James Buker

INSTRUCTIONS: Use typewriter or ball point pen. PLEASE PRESS FIRMLY and PRINT clearly. Please fill in blanks and check the correct answers. Send one copy to Kansas Department of Health and Environment, Bureau of Water, Geology Section, 1000 SW Jackson St., Suite 420, Topeka, Kansas 66612-1367. Telephone 785-296-5524. Send one copy to WATER WELL OWNER and retain one for your records. Include fee of \$5.00 for each constructed well. Visit us at