

**WATER WELL RECORD**

**Form WWC-5**

Division of Water Resources; App. No. \_\_\_\_\_

**1 LOCATION OF WATER WELL:** Fraction SW ¼ SW ¼ SE ¼ Section Number 25 Township Number T 13 S Range Number R 23 E  
 County: Johnson  
 Distance and direction from nearest town or city street address of well if located within city? 830 E. Santa Fe, Olathe KS **Global Positioning System** (decimal degrees, min. of 4 digits)  
 Latitude: \_\_\_\_\_  
 Longitude: \_\_\_\_\_  
 Elevation: \_\_\_\_\_  
 Datum: \_\_\_\_\_  
 Data Collection Method: \_\_\_\_\_

**2 WATER WELL OWNER:** Santa Fe Services  
 RR#, St. Address, Box # : PO Box 71  
 City, State, ZIP Code : Lawrene KS 66044

**3 LOCATE WELL'S LOCATON WITH AN "X" IN SECTION BOX:**

N	
NW	NE
SW	SE
S	

**4 DEPTH OF COMPLETED WELL** 13 ft. **MW8**  
 Depth(s) Groundwater Encountered 1 \_\_\_\_\_ ft. 2 \_\_\_\_\_ ft. 3 \_\_\_\_\_ ft.  
 WELL'S STATIC WATER LEVEL \_\_\_\_\_ ft. below land surface measured on mo/day/yr  
 Pump test data: Well water was \_\_\_\_\_ ft. after \_\_\_\_\_ hours pumping \_\_\_\_\_ gpm  
 Est. Yield \_\_\_\_\_ gpm: Well water was \_\_\_\_\_ ft. after \_\_\_\_\_ hours pumping \_\_\_\_\_ gpm  
 WELL WATER TO BE USED AS: 5 Public water supply 8 Air conditioning 11 Injection well  
 1 Domestic 3 Feed lot 6 Oil field water supply 9 Dewatering 12 Other (Specify below)  
 2 Irrigation 4 Industrial 7 Domestic (lawn & garden)  Monitoring well  
 Was a chemical/bacteriological sample submitted to Department? Yes \_\_\_\_\_ No  ; If yes, mo/day/yr  
 Sample was submitted \_\_\_\_\_ Water Well Disinfected? Yes \_\_\_\_\_ No

**5 TYPE OF CASING USED:** 1 Steel 2  PVC 3 RMP (SR) 4 ABS 5 Wrought Iron 6 Asbestos-Cement 7 Fiberglass 8 Concrete tile 9 Other (specify below) CASING JOINTS: Glued \_\_\_\_\_ Clamped \_\_\_\_\_ Welded \_\_\_\_\_ Threaded

Blank casing diameter 2 in. to 3 ft., Dia \_\_\_\_\_ in. to \_\_\_\_\_ ft., Dia \_\_\_\_\_ in. to \_\_\_\_\_ ft.  
 Casing height below land surface \_\_\_\_\_ ft., Weight \_\_\_\_\_ lbs./ft. Wall thickness or gauge No. \_\_\_\_\_

**TYPE OF SCREEN OR PERFORATION MATERIAL:** 1 Steel 3 Stainless steel 5 Fiberglass 7  PVC 9 ABS 11 Other (specify) \_\_\_\_\_  
 2 Brass 4 Galvanized steel 6 Concrete tile 8 RM (SR) 10 Asbestos-Cement 12 None used (open hole)

**SCREEN OR PERFORATION OPENINGS ARE:** 1 Continuous slot 3  Mill slot 5 Gauze wrapped 7 Torch cut 9 Drilled holes 11 None (open hole)  
 2 Louvered shutter 4 Key punched 6 Wire wrapped 8 Saw Cut 10 Other (specify) \_\_\_\_\_

**SCREEN-PERFORATED INTERVALS:** From 3 ft. to 13 ft. From \_\_\_\_\_ ft. to \_\_\_\_\_ ft.  
 From \_\_\_\_\_ ft. to \_\_\_\_\_ ft. From \_\_\_\_\_ ft. to \_\_\_\_\_ ft.  
**GRAVEL PACK INTERVALS:** From 2 ft. to 13.65 ft. From \_\_\_\_\_ ft. to \_\_\_\_\_ ft.  
 From \_\_\_\_\_ ft. to \_\_\_\_\_ ft. From \_\_\_\_\_ ft. to \_\_\_\_\_ ft.

**6 GROUT MATERIAL:** 1 Neat cement 2 Cement grout 3  Bentonite 4  Other **Concrete: 0-1'**  
 Grout Intervals From 1 ft. to 2 ft. From \_\_\_\_\_ ft. to \_\_\_\_\_ ft. From \_\_\_\_\_ ft. to \_\_\_\_\_ ft.  
 What is the nearest source of possible contamination:  
 1 Septic tank 4 Lateral lines 7 Pit privy 10 Livestock pens 13 Insecticide Storage 16 Other (specify below)  
 2 Sewer lines 5 Cess pool 8 Sewage lagoon 11  Fuel storage 14 Abandoned water well  
 3 Watertight sewer lines 6 Seepage pit 9 Feedyard 12 Fertilizer storage 15 Oil well/ gas well  
 Direction from well? SW How many feet? ~200'

FROM	TO	LITHOLOGIC LOG	FROM	TO	PLUGGING INTERVALS
0	0.3	Concrete			
0.3	2	Black clay			
2	3	Black clay w/ some Fe nodules			
3	5	Black clay			
5	6	Light brown clay			
6	13.65	Light brown clay w/ Fe nodules			

**7 CONTRACTOR'S OR LANDOWNER'S CERTIFICATION:** This water well was  constructed,  reconstructed, or  plugged under my jurisdiction and was completed on (mo/day/year) 6/23/14 and this record is true to the best of my knowledge and belief.  
 Kansas Water Well Contractor's License No. 757. This Water Well Record was completed on (mo/day/year) 7/19/14  
 under the business name of Larsen & Associates, Inc. by (signature) \_\_\_\_\_

**INSTRUCTIONS:** Please fill in blanks or circle the correct answers. Send top three copies to Kansas Department of Health and Environment, Bureau of Water, Geology Section, 1000 SW Jackson St., Suite 420, Topeka, Kansas 66612-1367. Telephone 785-296-5522. Send one to WATER WELL OWNER and retain one for your records. Fee of \$5.00 for each constructed well. Visit us at <http://www.kdheks.gov/waterwell>.

JENNIFER

20-13-23E

NOTE: Figures exhibited within this report are only to be used within the context of this report. Placement of property lines, wells, structures, and roads is based on the available information from county appraiser maps, surveys, site visits, and/or previous vendor reports and should be considered approximate.

~~KAS 010~~

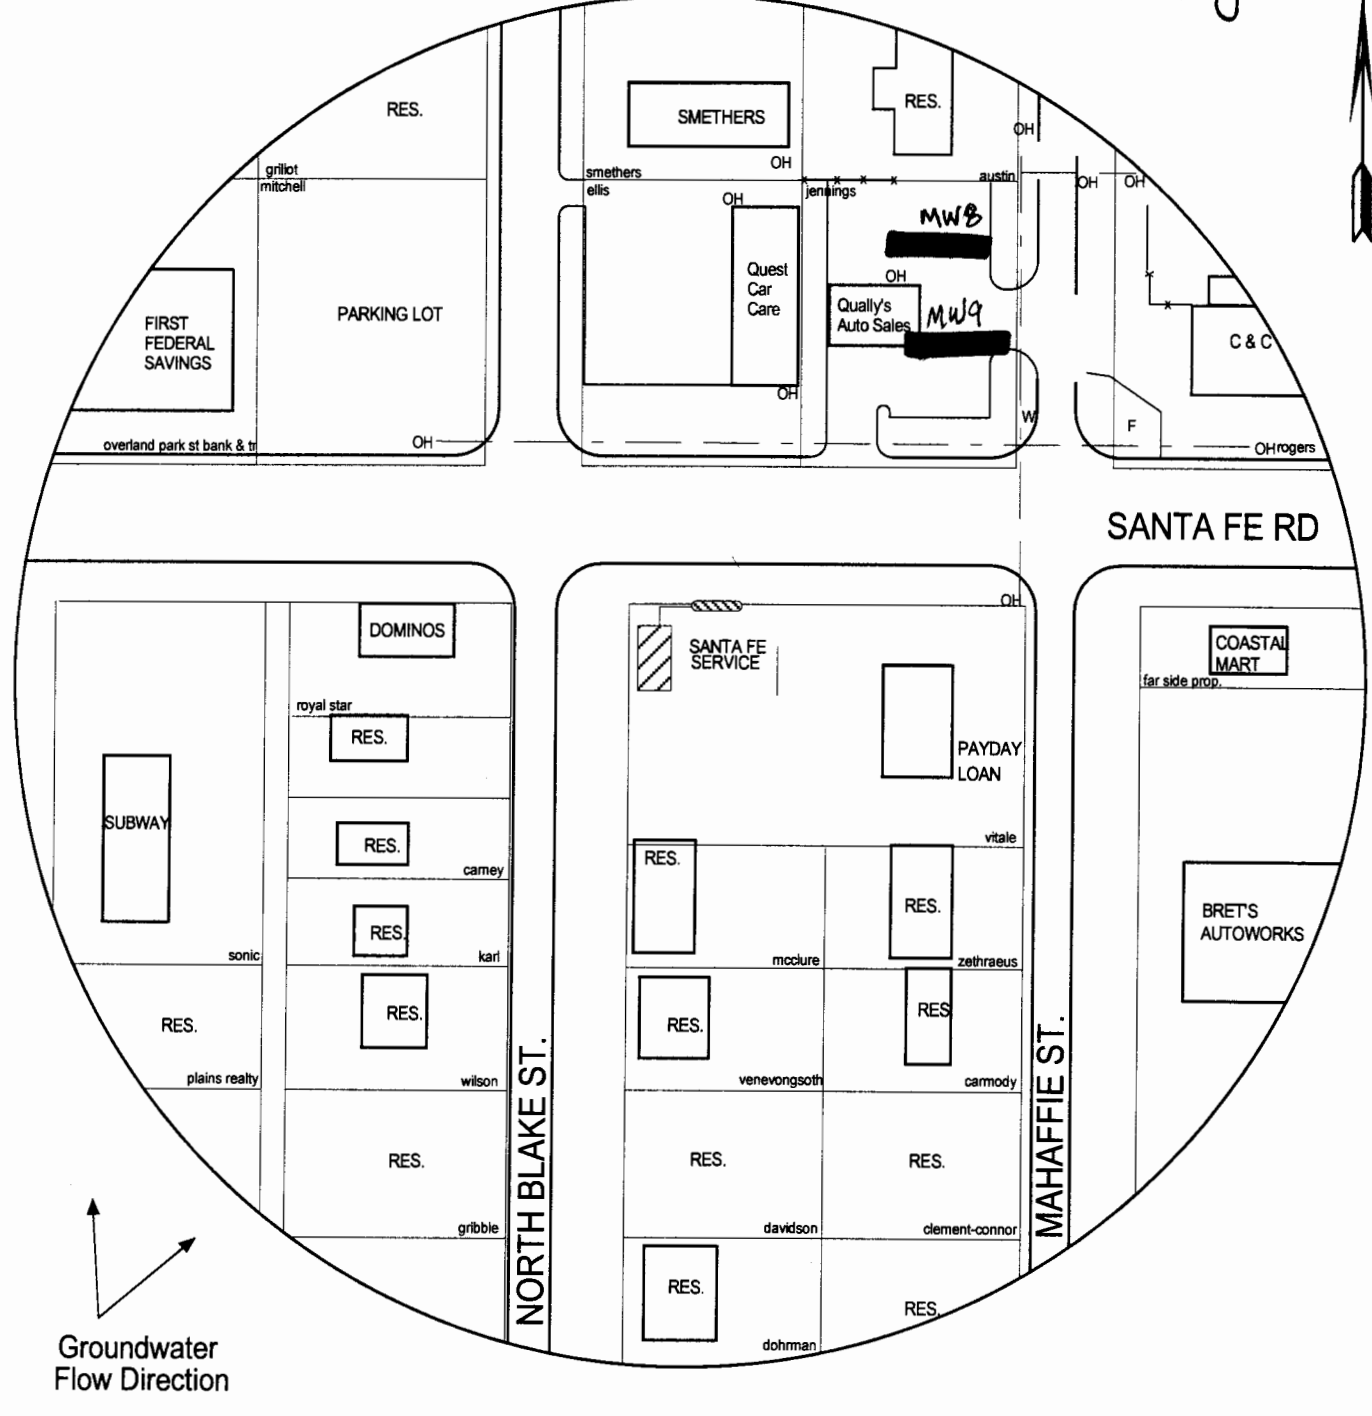


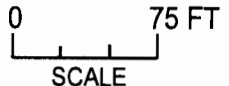
FIGURE 1 - SITE BASE MAP









 
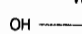
1311 E. 25th St., Suite B (785) 841-8707 office  
Lawrence, KS 66044 (785) 865-4282 fax

**PROJECT:**

Santa Fe Services  
803 East Santa Fe  
Olathe, KS  
KDHE ID: U4-046-12060  
Date: 5/7/14



**LEGEND:**

-  Former Pump Island and Product Line
-  Former UST Basin
-  Approximate Location of Property Line
-  Monitoring Well
-  Proposed Monitoring Well
-  Fire Hydrant
-  Water Meter
-  Overhead Line