

WATER WELL RECORD Form WWC-5

Division of Water Resources App. No.


MW-16

Original Record Correction Change in Well Use

Well ID

1 LOCATION OF WATER WELL: County: Johnson Fraction SE 1/4 NW 1/4 SE 1/4 SW 1/4 Section Number 25 Township Number T 13 S Range Number R 23 E W

2 WELL OWNER: Last Name: First: Street or Rural Address where well is located: M&M Bulk Plant 520 E Kansas City Road

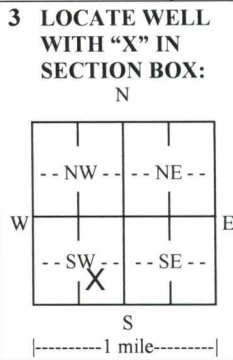

4 DEPTH OF COMPLETED WELL: 21 ft. Depth(s) Groundwater Encountered: 1) 20.5 ft. 2) ft. 3) ft. or 4) Dry Well 20.5 ft. WELL'S STATIC WATER LEVEL: 2/14/2022 below land surface, measured on (mo-day-yr) above land surface, measured on (mo-day-yr) Pump test data: Well water was after hours pumping gpm Well water was after hours pumping gpm Estimated Yield: gpm Bore Hole Diameter: 5.125 in. to 21 ft. and in. to ft.

5 Latitude: 38.886060 (decimal degrees) Longitude: -94.809657 (decimal degrees) Datum: WGS 84 NAD 83 NAD 27 Source for Latitude/Longitude: GPS (unit make/model: WAAS enabled? Yes No) Land Survey Topographic Map Online Mapper:

6 Elevation: ft. Ground Level TOC Source: Land Survey GPS Topographic Map Other

7 WELL WATER TO BE USED AS: 1. Domestic: Household Lawn & Garden Livestock Irrigation Feedlot Industrial 2. Public Water Supply: well ID Dewatering: how many wells? Aquifer Recharge: well ID Monitoring: well ID MW-16 Environmental Remediation: well ID Air Sparge Soil Vapor Extraction Recovery Injection Oil Field Water Supply: lease Test Hole: well ID Cased Uncased Geotechnical Geothermal: how many bores? Closed Loop Horizontal Vertical Open Loop Surface Discharge Inj. of Water Other (specify):

Was a chemical/bacteriological sample submitted to KDHE? Yes No If yes, date sample was submitted: Water well disinfected? Yes No

8 TYPE OF CASING USED: Steel PVC Other CASING JOINTS: Glued Clamped Welded Threaded Casing diameter 2 in. to 17 ft., Diameter in. to ft., Diameter in. to ft. Casing height above land surface 0 in. Weight lbs./ft. Wall thickness or gauge No. 40 TYPE OF SCREEN OR PERFORATION MATERIAL: Steel Stainless Steel PVC Other (Specify) Brass Galvanized Steel None used (open hole) SCREEN OR PERFORATION OPENINGS ARE: Continuous Slot Mill Slot Gauze Wrapped Torch Cut Drilled Holes Other (Specify) Louvered Shutter Key Punched Wire Wrapped Saw Cut None (Open Hole) SCREEN-PERFORATED INTERVALS: From 17 ft. to 21 ft., From ft. to ft., From ft. to ft. GRAVEL PACK INTERVALS: From 15 ft. to 21 ft., From ft. to ft., From ft. to ft.

9 GROUT MATERIAL: Neat cement Cement grout Bentonite Other Grout Intervals: From 0 ft. to 2 ft., From 2 ft. to 16 ft., From ft. to ft. Nearest source of possible contamination: No potential source of contamination within 200 ft. Septic Tank Lateral Lines Pit Privy Livestock Pens Insecticide Storage Sewer Lines Cess Pool Sewage Lagoon Fuel Storage Abandoned Water Well Watertight Sewer Lines Seepage Pit Feedyard Fertilizer Storage Oil Well/Gas Well Other (Specify) Direction from well? SW Distance from well? 137 ft.

Table with columns: FROM, TO, LITHOLOGIC LOG, FROM, TO, LITHO. LOG (cont.) or PLUGGING INTERVALS. Rows: 0-6 Clay, 6-17 Shale, 17-21 Limestone. Includes a Notes section.

11 CONTRACTOR'S OR LANDOWNER'S CERTIFICATION: This water well was constructed, reconstructed, or plugged under my jurisdiction and was completed on (mo-day-year) 01/27/2022 and this record is true to the best of my knowledge and belief. Kansas Water Well Contractor's License No. 551. This Water Well Record was completed on (mo-day-year) 01/27/2022 under the business name of Associated Environmental Industries Corp.