

**WATER WELL PLUGGING RECORD Form WWC-5P KSA 82a-1212 ID NO.**

MW11

**1 LOCATION OF WATER WELL:** Fraction SW 1/4 SE 1/4 SW 1/4 SE 1/4 Section Number 25 Township Number T 13 S Range Number 23  E  W  
 County: JOHNSON  
 Street/Rural Address of Well Location; if unknown, distance & direction from nearest town or intersection: If at owner's address, check here  900 E. SANTA FE, OLATHE, KS  
**Global Positioning Systems (GPS) information:**  
 Latitude: 38.88426 (in decimal degrees)  
 Longitude: 94.80394 (in decimal degrees)  
 Elevation: 1048.38  
 Horizontal Datum:  WGS84,  NAD83,  NAD27  
 Collection Method:

**2 WATER WELL OWNER:** KDHE  
 RR#, St. Address, Box #: 1000 SW JACKSON  
 City, State ZIP Code: TOPEKA, KS 66612  
 GPS unit (Make/Model: \_\_\_\_\_)  
 Digital Map/Photo,  Topographic Map,  Land Survey  
 Est. Accuracy:  < 3 m,  3-5 m,  5-15 m,  > 15 m

**3 MARK WELL'S LOCATION WITH AN "X" IN SECTION BOX:**

**4 DEPTH OF WELL** 13.02 ft.  
 WELL'S STATIC WATER LEVEL 5.86 ft  
 WELL WAS USED AS:  
 Domestic  Public Water Supply  Dewatering  
 Irrigation  Oil Field Water Supply  Monitoring  
 Feedlot  Domestic (Lawn & Garden)  Injection Well  
 Industrial  Air Conditioning  Other \_\_\_\_\_  
 Was a chemical/bacteriological sample submitted to Department? Yes  No


**5 TYPE OF BLANK CASING USED:**  
 Steel  RMP (SR)  Wrought  Fiberglass  Other (Specify below)  
 PVC  ABS  Asbestos-Cement  Concrete Tile  
 Blank casing diameter 2 in. Was casing pulled? Yes  No  If yes, how much 3'  
 Casing height above or below land surface \_\_\_\_\_ in.

**6 GROUT PLUG MATERIAL:**  Neat cement  Cement grout  Bentonite  Other ASPHALT 0-0.5  
 Grout Plug Intervals: From 0.5 ft. to 13.02 ft., From \_\_\_\_\_ ft. to \_\_\_\_\_ ft., From \_\_\_\_\_ ft. to \_\_\_\_\_ ft.  
 What is the nearest source of possible contamination:  
 Septic tank  Seepage pit  Fuel storage  Other (specify below)  
 Sewer lines  Pit privy  Fertilizer storage  
 Watertight sewer lines  Sewage lagoon  Insecticide storage  
 Lateral lines  Feedyard  Abandoned water well Direction from well? WEST  
 Cess pool  Livestock pens  Oil well/Gas well How many feet? 40

FROM	TO	PLUGGING MATERIALS	FROM	TO	PLUGGING MATERIALS
0	0.5	ASPHALT			
0.5	13.02	BENTONITE			

**7 CONTRACTOR'S OR LANDOWNER'S CERTIFICATION:** This water well was plugged under my jurisdiction and was completed on (mo/day/year) 4/4/22 and this record is true to the best of my knowledge and belief. Kansas Water Well Contractor's License No. 585. This Water Well Record was completed on (mo/day/year) 5/16/22 under the business name of ASSOCIATED ENVIRONMENTAL INC. by (signature) \_\_\_\_\_

Send one white copy to Kansas Department of Health & Environment, Geology Section, 1000 SW Jackson Street, Ste. 420, Topeka, KS 66612-1367. Send one copy to WATER WELL OWNER and retain one for your records.  
 Visit us at <http://www.kdheks.gov/waterwell/index.html> Telephone 785-296-5524.

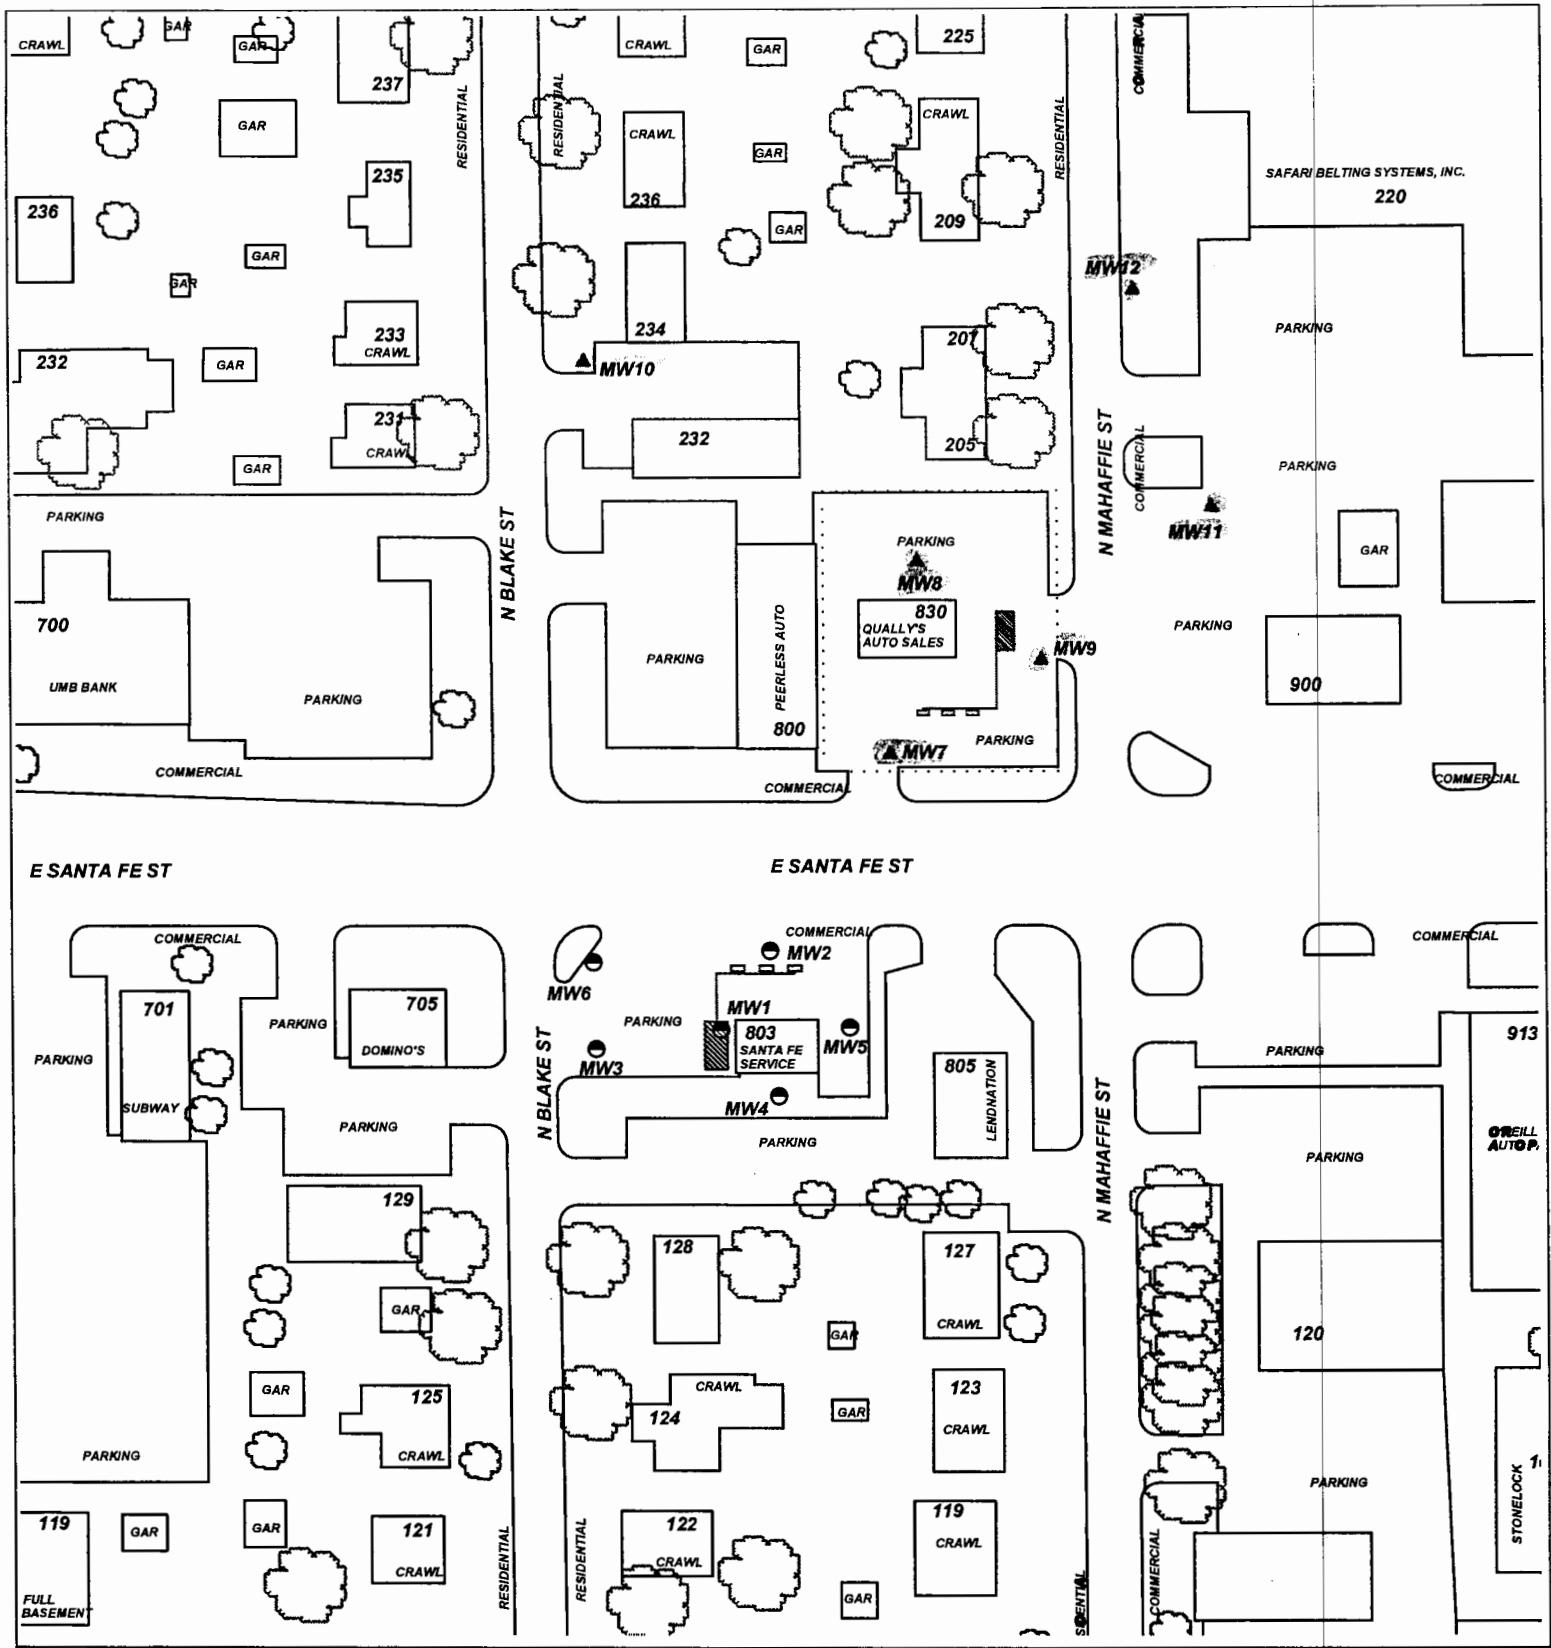

**PROJECT:** OLD SERVICE STATION

**ADDRESS:** 830 SANTA FE & MAHAFFIE

**LOCATION:** OLATHE, KS

**DRAWN BY:** B. STALNAKER **DATE:** 12/12/18

**REVISED BY:** B. STALNAKER **DATE:** 5/16/22

**AEI JOB #:** TM243 **KDHE JOB #:** U4-046-00582

**TITLE:** FIGURE 2.1  
AREA BASE MAP  
350' RADIUS

**ASSOCIATED ENVIRONMENTAL INC.**

**LEGEND:**

- = FORMER UST BASIN AND PUMP ISLANDS NORTH (U4-046-00582) SOUTH (U4-046-12060)
- = EXISTING SANTA FE SERVICE WELLS (U4-046-12060)
- = MONITORING WELL
- = PLUGGED/DESTROYED WELL
- = SUBJECT PROPERTY

**SCALE:** 1" = 100'

**NOTES:**