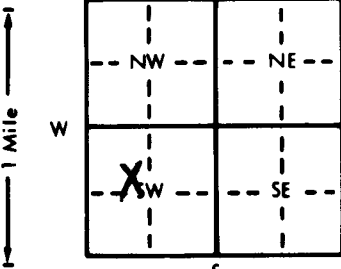


1 LOCATION OF WATER WELL:		Fraction		Section Number		Township Number		Range Number			
County: Johnson		SW 1/4 NW 1/4 SE 1/4		30		T 13 S		R 24 EW			
Distance and direction from nearest town or city street address of well if located within city?											
400 North Rogers Road, Olathe, KS											
2 WATER WELL OWNER: AlliedSignal MW-4											
RR#, St. Address, Box # : 400 North Rogers Road Board of Agriculture, Division of Water Resources											
City, State, ZIP Code : Olathe, KS 66062 Application Number:											
3 LOCATE WELL'S LOCATION WITH AN "X" IN SECTION BOX:		4 DEPTH OF COMPLETED WELL: 10.5 ft. ELEVATION: 13.91 ft. below land surface measured on mo/day/yr 3/22/96									
		Depth(s) Groundwater Encountered 1. 10.5 ft. 2. ft. 3. ft.									
		WELL'S STATIC WATER LEVEL 13.91 ft. below land surface measured on mo/day/yr 3/22/96									
		Pump test data: Well water was ft. after hours pumping gpm									
		Est. Yield gpm: Well water was ft. after hours pumping gpm									
Bore Hole Diameter 6 in. to ft. and in. to ft.											
WELL WATER TO BE USED AS:											
1 Domestic 3 Feedlot 6 Oil field water supply 9 Dewatering 11 Injection well											
2 Irrigation 4 Industrial 7 Lawn and garden only 10 Monitoring well 12 Other (Specify below)											
Was a chemical/bacteriological sample submitted to Department? Yes No X ; If yes, mo/day/yr sample was submitted											
Water Well Disinfected? Yes No X											
5 TYPE OF BLANK CASING USED:											
1 Steel 3 RMP (SR) 5 Wrought iron 8 Concrete tile CASING JOINTS: Glued Clamped											
2 PVC 4 ABS 6 Asbestos-Cement 9 Other (specify below) Welded											
Blank casing diameter 1 in. to 13 in. Dia. in. to ft. Dia. in. to ft.											
Casing height above land surface 0.0 in., weight 0.70 lbs./ft. Wall thickness or gauge No. sch 40											
TYPE OF SCREEN OR PERFORATION MATERIAL:											
1 Steel 3 Stainless steel 5 Fiberglass 8 RMP (SR) 10 Asbestos-cement											
2 Brass 4 Galvanized steel 6 Concrete tile 9 ABS 11 Other (specify)											
12 None used (open hole)											
SCREEN OR PERFORATION OPENINGS ARE:											
1 Continuous slot 2 Mill slot 3 Gauzed wrapped 8 Saw cut 11 None (open hole)											
2 Louvered shutter 4 Key punched 6 Wire wrapped 9 Drilled holes											
7 Torch cut 10 Other (specify)											
SCREEN-PERFORATED INTERVALS: From 18.5 ft. to 13 ft. From ft. to ft.											
From ft. to ft. From ft. to ft.											
GRAVEL PACK INTERVALS: From 13 ft. to 3 ft. From ft. to ft.											
From ft. to ft. From ft. to ft.											
6 GROUT MATERIAL: 1 Neat cement 2 Cement grout 3 Bentonite 4 Other											
Grout Intervals: From 3 ft. to 1 ft. From ft. to ft. From ft. to ft.											
What is the nearest source of possible contamination:											
1 Septic tank 4 Lateral lines 7 Pit privy 10 Livestock pens 14 Abandoned water well											
2 Sewer lines 5 Cess pool 8 Sewage lagoon 11 Fuel storage 15 Oil well/Gas well											
3 Watertight sewer lines 6 Seepage pit 9 Feedyard 12 Fertilizer storage 16 Other (specify below)											
13 Insecticide storage Industrial											
Direction from well South west How many feet? 75											
FROM		TO		LITHOLOGIC LOG		FROM		TO		PLUGGING INTERVALS	
0		8.0		1. Brown SILTY CLAY, FIRM-STIFF							
8.0		12.0		Red Brown SILTY CLAY, STIFF							
12.0		15.0		Brown SILTY CLAY, STIFF-HARD							
15.0		16.0		LIMESTONE							
7 CONTRACTOR'S OR LANDOWNER'S CERTIFICATION: This water well was (1) constructed, (2) reconstructed, or (3) plugged under my jurisdiction and was completed on (mo/day/year) 3/21/96 and this record is true to the best of my knowledge and belief. Kansas Water Well Contractor's License No. 602 This Water Well Record was completed on (mo/day/yr) 4/10/96 under the business name of Hydro-LOGIC, Inc. by (signature) [Signature]											
INSTRUCTIONS: Use typewriter or ball point pen. PLEASE PRESS FIRMLY and PRINT clearly. Please fill in blanks, underline or circle the correct answers. Send top three copies to Kansas Department of Health and Environment, Bureau of Water, Topeka, Kansas 66620-0001. Telephone: 913-296-5545. Send one to WATER WELL OWNER and retain one for your records.											