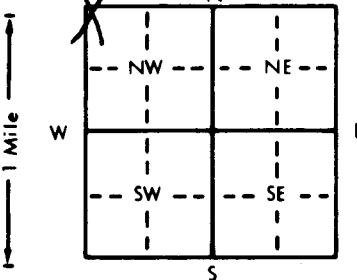


1 LOCATION OF WATER WELL:		Fraction	Section Number	Township Number	Range Number
County: <u>Johnson</u>		<u>NW 1/4 NW 1/4 NW 1/4</u>	<u>31</u>	<u>T 13 S</u>	<u>R 24 E</u>
Distance and direction from nearest town or city street address of well if located within city? <u>1301 Santa Fe Olathe, KS</u>					
2 WATER WELL OWNER:		MW1 Board of Agriculture, Division of Water Resources Application Number:			
RR#, St. Address, Box #		<u>P.O. Box 419119</u>			
City, State, ZIP Code		<u>KC, Mo</u>			
3 LOCATE WELL'S LOCATION WITH AN "X" IN SECTION BOX:		4 DEPTH OF COMPLETED WELL: <u>12</u> ft. ELEVATION:			
		Depth(s) Groundwater Encountered 1. ft. 2. ft. 3. ft. WELL'S STATIC WATER LEVEL ft. below land surface measured on mo/day/yr Pump test data: Well water was ft. after hours pumping gpm Est. Yield gpm Well water was ft. after hours pumping gpm Bore Hole Diameter in. to ft., and in. to ft. WELL WATER TO BE USED AS: 5 Public water supply 8 Air conditioning 11 Injection well 1 Domestic 3 Feedlot 6 Oil field water supply 9 Dewatering 12 Other (Specify below) 2 Irrigation 4 Industrial 7 Lawn and garden only 10 Monitoring well Was a chemical/bacteriological sample submitted to Department? Yes. No. If yes, mo/day/yr sample was submitted Water Well Disinfected? Yes No			
5 TYPE OF BLANK CASING USED:		CASING JOINTS: Glued Clamped			
1 Steel 3 RMP (SR) 5 Wrought iron 8 Concrete tile		Welded			
2 PVC 4 ABS 6 Asbestos-Cement 9 Other (specify below)		Threaded			
Blank casing diameter 2 in. to ft., Dia in. to ft., Dia in. to ft.					
Casing height above land surface 0 in., weight lbs./ft. Wall thickness or gauge No.					
TYPE OF SCREEN OR PERFORATION MATERIAL:		10 Asbestos-cement			
1 Steel 3 Stainless steel 5 Fiberglass 8 RMP (SR)		11 Other (specify)			
2 Brass 4 Galvanized steel 6 Concrete tile 9 ABS		12 None used (open hole)			
SCREEN OR PERFORATION OPENINGS ARE:		8 Saw cut 11 None (open hole)			
1 Continuous slot 3 Mill slot 5 Gauzed wrapped 6 Wire wrapped 9 Drilled holes		10 Other (specify)			
2 Louvered shutter 4 Key punched 7 Torch cut					
SCREEN-PERFORATED INTERVALS: From 2 ft. to 12 ft., From ft. to ft.					
GRAVEL PACK INTERVALS: From 1.5 ft. to 12 ft., From ft. to ft.					
6 GROUT MATERIAL: 1 Neat cement 2 Cement grout 3 Bentonite 4 Other					
Grout Intervals: From 0 ft. to 1 ft., From 1 ft. to 1.5 ft., From ft. to ft.					
What is the nearest source of possible contamination:		10 Livestock pens 14 Abandoned water well			
1 Septic tank 4 Lateral lines 7 Pit privy 11 Fuel storage 15 Oil well/Gas well		16 Other (specify below) <u>US 76</u>			
2 Sewer lines 5 Cess pool 8 Sewage lagoon 12 Fertilizer storage					
3 Watertight sewer lines 6 Seepage pit 9 Feedyard 13 Insecticide storage					
Direction from well?		How many feet?			
FROM	TO	LITHOLOGIC LOG	FROM	TO	PLUGGING INTERVALS
0	6"	Concrete			
5	7	Fill			
10	12	Clay, shale fragments, minor silt, brown gray w/ orange mottles			
u4 046123					
7 CONTRACTOR'S OR LANDOWNER'S CERTIFICATION: This water well was (1) constructed, (2) reconstructed, or (3) plugged under my jurisdiction and was completed on (mo/day/year) <u>7/5/97</u> and this record is true to the best of my knowledge and belief. Kansas Water Well Contractor's License No. <u>483</u> This Water Well Record was completed on (mo/day/yr) <u>8/5/97</u> under the business name of <u>TEST</u> by (signature) <u>B. Roman by 4</u>					