

1 LOCATION OF WATER WELL:	Fraction	Section Number	Township Number	Range Number
County: Johnson	SW ¼ NE MM ¼ NW ¼	9	T 13 S	R 24 E/W


1 LOCATION OF WATER WELL:	Fraction	Section Number	Township Number	Range Number
County: Johnson	SW ¼ NE MM ¼ NW ¼	9	T 13 S	R 24 E/W

Distance and direction from nearest town or city street address of well if located within city?
14600 West 106th Street, Lenexa, KS/South parking lot

2 WATER WELL OWNER:Deluxe Corporation
RR#, St. Address, Box # P.O. Box 64399
City, State, ZIP Code St. Paul, MN 55164

3 LOCATE WELL'S LOCATION WITH AN "X" IN SECTION BOX: 4 DEPTH OF COMPLETED WELL: 13.5 ft. ELEVATION: 1033.41

Depth(s) Groundwater Encountered 1. NA ft. 2. ft. 3. ft.

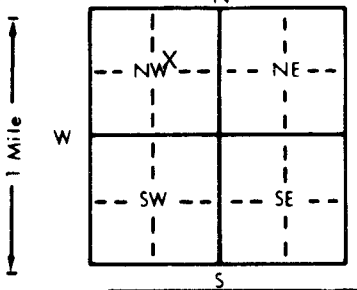

WELL'S STATIC WATER LEVEL NA . . . ft. below land surface measured on mo/day/yr

Pump test data: Well water was ft. after hours pumping gpm

Est. Yield gpm: Well water was ft. after hours pumping gpm

Bore Hole Diameter 6.0 in. to 13.5 ft. and in. to ft.

WELL WATER TO BE USED AS:

5 Public water supply	8 Air conditioning	11 Injection well		
1 Domestic	3 Feedlot	6 Oil field water supply	9 Dewatering	12 Other (Specify below)
2 Irrigation	4 Industrial	7 Lawn and garden only	10 Monitoring well	MW 7./ST. 7

Was a chemical/bacteriological sample submitted to Department? Yes No X; If yes, mo/day/yr sample was submitted

Water Well Disinfected? Yes No X

5	TYPE OF BLANK CASING USED:		5 Wrought iron	8 Concrete tile	CASING JOINTS: Glued Clamped	
	1 Steel	3 RMP (SR)	6 Asbestos-Cement	9 Other (specify below)	Welded	
	2 <u>PVC</u>	4 ABS	7 Fiberglass		Threaded . . . <u>X</u>	
Blank casing diameter 2 in. to 3.5 ft. Dia in. to ft. Dia in. to ft.						
Casing height above land surface 0 in. weight lbs./ft. Wall thickness or gauge No. Sch. 40						

TYPE OF SCREEN OR PERFORATION MATERIAL:		7 PVC	10 Asbestos-cement
1 Steel	3 Stainless steel	8 RMP (SR)	11 Other (specify)
2 Brass	4 Galvanized steel	9 ABS	12 None used (open hole)
SCREEN OR PERFORATION OPENINGS ARE:		5 Gauzed wrapped	8 Saw cut
1 Continuous slot	3 Mill slot	6 Wire wrapped	9 Drilled holes
2 Louvered shutter	4 Key punched	7 Torch cut	10 Other (specify)
SCREEN-PERFORATED INTERVALS:		5.5 ft. to 13.5 ft.	From ft. to ft.
		From ft. to ft.	From ft. to ft.
GRAVEL PACK INTERVALS:		From ft. to ft.	From ft. to ft.
		From ft. to ft.	From ft. to ft.

6	GROUT MATERIAL:		1 Neat cement	2 Cement grout	3 Bentonite	4 Other	
	Grout Intervals:	From	5	ft. to	4	5	
		From	4	5	ft. to	ft.	
	What is the nearest source of possible contamination:					10 Livestock pens	14 Abandoned water well
	1 Septic tank	4 Lateral lines	7 Pit privy	11 Fuel storage	15 Oil well/Gas well		
	2 Sewer lines	5 Cess pool	8 Sewage lagoon	12 Fertilizer storage	16 Other (specify below)		
	3 Watertight sewer lines	6 Seepage pit	9 Feedyard	13 Insecticide storage			
	Direction from well?				How many feet?		

[illegible]

7. CONTRACTOR'S OR LANDOWNER'S CERTIFICATION: This water well was (1) constructed, (2) reconstructed, or (3) plugged under my jurisdiction and was completed on (mo/day/year) 7/9/97 and this record is true to the best of my knowledge and belief. Kansas Water Well Contractor's License No. 549 This Water Well Record was completed on (mo/day/yr) 7/25/97 under the business name of J S R Drilling Services, Inc. by (signature) Raymond Coors