


1 LOCATION OF WATER WELL:	Fraction	Section Number	Township Number	Range Number
County: Johnson	SW 1/4 NE 1/4 NW 1/4	9	T 13 S	R 24 E

Distance and direction from nearest town or city street address of well if located within city?
14600 West 106th Street, Lenexa, KS/South parking lot

2] WATER WELL OWNERDeluxe Corporation
RR#, St. Address, Box # P.O. Box 64399
City, State, ZIP Code St. Paul, MN 55164

3	LOCATE WELL'S LOCATION WITH AN "X" IN SECTION BOX:	4	DEPTH OF COMPLETED WELL.....12	ft.	ELEVATION:.....1034.03
			Depth(s) Groundwater Encountered 1.....NA	ft.	2.....ft. 3.....ft.

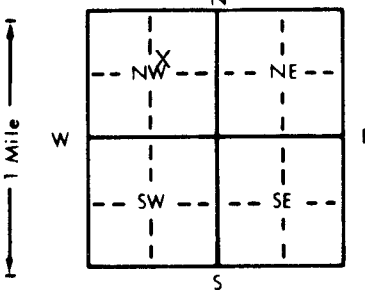

4 DEPTH OF COMPLETED WELL.....12 ft. ELEVATION:1031.03

Depth(s) Groundwater Encountered 1.....NA.....ft. 2.....ft. 3.....ft.

WELL'S STATIC WATER LEVEL.....NA.....ft. below land surface measured on mo/day/yr

Pump test data: Well water was.....ft. after.....hours pumping.....gpm

Est. Yield.....gpm: Well water was.....ft. after.....hours pumping.....gpm

Bore Hole Diameter.....6.0 in. to.....12 ft. and.....in. to.....ft.

WELL WATER TO BE USED AS:

1 Domestic	3 Feedlot	6 Oil field water supply	9 Dewatering	12 Other (Specify below)
2 Irrigation	4 Industrial	7 Lawn and garden only	10 Monitoring well	

Was a chemical/bacteriological sample submitted to Department? Yes.....No.....X.....; If yes, mo/day/yr sample was submitted

Water Well Disinfected? Yes.....No.....X

5	TYPE OF BLANK CASING USED:		5 Wrought iron	8 Concrete tile	CASING JOINTS: Glued Clamped Welded Threaded . . X
	1 Steel	3 RMP (SR)	6 Asbestos-Cement	9 Other (specify below)	
	2 PVC	4 ABS	7 Fiberglass		

Blank casing diameter 2 in. to 4 ft. Dia in. to ft., Dia in. to ft.
Casing height above land surface 0 in., weight lbs./ft. Wall thickness or gauge No. Sch. 40

TYPE OF SCREEN OR PERFORATION MATERIAL:			7 PVC	10 Asbestos-cement
1 Steel	3 Stainless steel	5 Fiberglass	8 RMP (SR)	11 Other (specify)
2 Brass	4 Galvanized steel	6 Concrete tile	9 ABS	12 None used (open hole)

SCREEN OR PERFORATION OPENINGS ARE:

1 Continuous slot	3 Mill slot	5 Gauzed wrapped	8 Saw cut	11 None (open hole)
2 Louvered shutter	4 Key punched	6 Wire wrapped	9 Drilled holes	
		7 Torch cut	10 Other (specify)	

SCREEN-PERFORATED INTERVALS:	From	4	ft. to	12	ft., From		ft. to		ft.
	From		ft. to		ft., From		ft. to		ft.
GRAVEL PACK INTERVALS:	From		ft. to		ft., From		ft. to		ft.
	From		ft. to		ft., From		ft. to		ft.

6 GROUT MATERIAL: 1 Neat cement 2 Cement grout 3 Bentonite 4 Other



What is the nearest source of possible contamination:

1 Septic tank	4 Lateral lines	7 Pit privy	10 Livestock pens	14 Abandoned water well
2 Sewer lines	5 Cess pool	8 Sewage lagoon	11 Fuel storage	15 Oil well/Gas well
3 Watertight sewer lines	6 Seepage pit	9 Feedyard	12 Fertilizer storage	16 Other (specify below)
			13 Insecticide storage	

How many feet?

Direction from well? _____ How many feet? _____

[illegible]

7 CONTRACTOR'S OR LANDOWNER'S CERTIFICATION: This water well was (1) constructed, (2) reconstructed, or (3) plugged under my jurisdiction and was completed on (mo/day/year) ... 7/9/97 ... and this record is true to the best of my knowledge and belief. Kansas Water Well Contractor's License No. ... 5549 ... This Water Well Record was completed on (mo/day/yr) ... 7/25/97 ... under the business name of J & R Drilling Services, Inc. by (signature) Raymond Evans