


1 LOCATION OF WATER WELL: Fraction Section Number Township Number Range Number  
 County: Johnson NW 1/4 NW 1/4 SW 1/4 9 T 13 S R 24 E

Distance and direction from nearest town or city street address of well if located within city?

14650 Santa Fe Trail Drive Lenexa

2 WATER WELL OWNER: United Parcel Service MW-2  
 RR#, St. Address, Box #: 14650 Santa Fe Trail Drive  
 City, State, ZIP Code: Lenexa KS 66215  
 Board of Agriculture, Division of Water Resources  
 Application Number:

3 LOCATE WELL'S LOCATION WITH AN "X" IN SECTION BOX: 4 DEPTH OF COMPLETED WELL: 25 ft. ELEVATION:

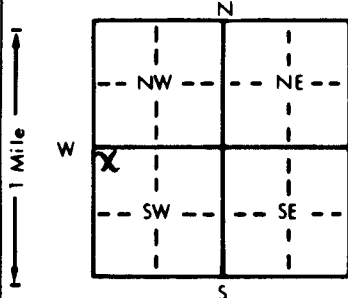

Depth(s) Groundwater Encountered 1. 20 ft. 2. ft. 3. ft.  
 WELL'S STATIC WATER LEVEL 18.5 ft. below land surface measured on mo/day/yr 2-8-90  
 Pump test data: Well water was ft. after hours pumping gpm  
 Est. Yield gpm: Well water was ft. after hours pumping gpm  
 Bore Hole Diameter 7.25 in. to 25 ft., and in. to ft.  
 WELL WATER TO BE USED AS:  
 5 Public water supply 8 Air conditioning 11 Injection well  
 1 Domestic 3 Feedlot 6 Oil field water supply 9 Dewatering 12 Other (Specify below)  
 2 Irrigation 4 Industrial 7 Lawn and garden only 10 Monitoring well  
 Was a chemical/bacteriological sample submitted to Department? Yes No X; If yes, mo/day/yr sample was submitted  
 Water Well Disinfected? Yes No X

5 TYPE OF BLANK CASING USED:  
 1 Steel 3 RMP (SR) 5 Wrought iron 8 Concrete tile CASING JOINTS: Glued Clamped  
2 PVC 4 ABS 6 Asbestos-Cement 9 Other (specify below) Welded  
 7 Fiberglass Threaded X

Blank casing diameter 2 in. to 10 ft., Dia in. to ft., Dia in. to ft.  
 Casing height above land surface 0 in., weight lbs./ft. Wall thickness or gauge No. SC 40

TYPE OF SCREEN OR PERFORATION MATERIAL:  
 1 Steel 3 Stainless steel 5 Fiberglass 8 RMP (SR) 10 Asbestos-cement  
 2 Brass 4 Galvanized steel 6 Concrete tile 9 ABS 11 Other (specify)  
 12 None used (open hole)

SCREEN OR PERFORATION OPENINGS ARE:  
 1 Continuous slot 3 Mill slot 5 Gauzed wrapped 8 Saw cut 11 None (open hole)  
 2 Louvered shutter 4 Key punched 6 Wire wrapped 9 Drilled holes  
 7 Torch cut 10 Other (specify)

SCREEN-PERFORATED INTERVALS: From 10 ft. to 25 ft., From ft. to ft.  
 From ft. to ft., From ft. to ft.

GRAVEL PACK INTERVALS: From 8 ft. to 25 ft., From ft. to ft.  
 From ft. to ft., From ft. to ft.

6 GROUT MATERIAL: 1 Neat cement 2 Cement grout 3 Bentonite 4 Other  
 Grout Intervals: From 0 ft. to 5 ft., From 5 ft. to 8 ft., From ft. to ft.

What is the nearest source of possible contamination:  
 1 Septic tank 4 Lateral lines 7 Pit privy 10 Livestock pens 14 Abandoned water well  
 2 Sewer lines 5 Cess pool 8 Sewage lagoon 11 Fuel storage 15 Oil well/Gas well  
 3 Watertight sewer lines 6 Seepage pit 9 Feedyard 12 Fertilizer storage 16 Other (specify below)  
 13 Insecticide storage

Direction from well? North How many feet? 13

FROM TO LITHOLOGIC LOG FROM TO PLUGGING INTERVALS

0 14 Red brown, silty CLAY  
14 15 Rock Fill  
15 20 Red brown, fine sandy CLAY  
20 25 Gray AA

Grout and casing height variance granted

7 CONTRACTOR'S OR LANDOWNER'S CERTIFICATION: This water well was (1) constructed (2) reconstructed, or (3) plugged under my jurisdiction and was completed on (mo/day/year) 2-7-90 and this record is true to the best of my knowledge and belief. Kansas  
 Water Well Contractor's License No. 54 This Water Well Record was completed on (mo/day/yr) 3-5-90  
 under the business name of Groundwater Tech. Inc. by (signature) Benny Ireland