


1 LOCATION OF WATER WELL: County: **Johnson** Fraction: **SE 1/4 SW 1/4 SW 1/4** Section Number: **30** Township Number: **T 13 S** Range Number: **R 24 W**

Distance and direction from nearest town or city street address of well if located within city?
Property immediately east of Texaco station, 1800 Santa Fe, Olathe

2 WATER WELL OWNER: **Texaco Refining & Marketing Inc.**
 RR#, St. Address, Box #: **1437 S. Boulder**
 City, State, ZIP Code: **Tulsa, OK 74119**
 Board of Agriculture, Division of Water Resources
 Application Number:

3 LOCATE WELL'S LOCATION WITH AN "X" IN SECTION BOX:

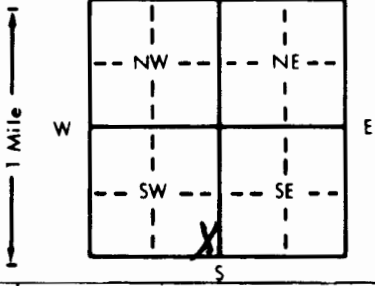

4 DEPTH OF COMPLETED WELL: **7.5** ft. ELEVATION: **92.22**
 Depth(s) Groundwater Encountered 1. **3.00** ft. 2. ft. 3. ft.
 WELL'S STATIC WATER LEVEL **3.12** ft. below land surface measured on mo/day/yr **5/1/91**
 Pump test data: Well water was ft. after hours pumping gpm
 Est. Yield gpm: Well water was ft. after hours pumping gpm
 Bore Hole Diameter **7.25** in. to **7.5** ft., and in. to ft.
 WELL WATER TO BE USED AS:
 5 Public water supply 8 Air conditioning 11 Injection well
 1 Domestic 3 Feedlot 6 Oil field water supply 9 Dewatering 12 Other (Specify below)
 2 Irrigation 4 Industrial 7 Lawn and garden only **10 Monitoring well**
 Was a chemical/bacteriological sample submitted to Department? Yes No If yes, mo/day/yr sample was submitted
 Water Well Disinfected? Yes No

5 TYPE OF BLANK CASING USED:
 1 Steel 3 RMP (SR) 5 Wrought iron 8 Concrete tile CASING JOINTS: Glued Clamped
 2 PVC 4 ABS 6 Asbestos-Cement 9 Other (specify below) Welded
 Blank casing diameter **4** in. to **3.2** ft., Dia. in. to ft., Dia. in. to ft.
 Casing height above land surface **Ground Level** in., weight lbs./ft. Wall thickness or gauge No. **Sch. 40**
 TYPE OF SCREEN OR PERFORATION MATERIAL: **PVC**
 1 Steel 3 Stainless steel 5 Fiberglass 8 RMP (SR) 10 Asbestos-cement
 2 Brass 4 Galvanized steel 6 Concrete tile 9 ABS 11 Other (specify)
 12 None used (open hole)
 SCREEN OR PERFORATION OPENINGS ARE:
 1 Continuous slot 3 Mill slot 5 Gauzed wrapped 8 Saw cut 11 None (open hole)
 2 Louvered shutter 4 Key punched 6 Wire wrapped 9 Drilled holes
 7 Torch cut 10 Other (specify)

SCREEN-PERFORATED INTERVALS: From **2** ft. to **7.5** ft., From ft. to ft.
 From ft. to ft., From ft. to ft.
 GRAVEL PACK INTERVALS: From **1.5** ft. to **7.5** ft., From ft. to ft.
 From ft. to ft., From ft. to ft.

6 GROUT MATERIAL: **1** Neat cement 2 Cement grout 3 Bentonite 4 Other
 Grout Intervals: From **0.5** ft. to **1.5** ft., From **0** ft. to **0.5** ft., From ft. to ft.
 What is the nearest source of possible contamination:
 1 Septic tank 4 Lateral lines 7 Pit privy **11** Fuel storage 14 Abandoned water well
 2 Sewer lines 5 Cess pool 8 Sewage lagoon 12 Fertilizer storage 15 Oil well/Gas well
 3 Watertight sewer lines 6 Seepage pit 9 Feedyard 13 Insecticide storage 16 Other (specify below)
 Direction from well? **West**
 How many feet? **~100**

FROM	TO	LITHOLOGIC LOG	FROM	TO	PLUGGING INTERVALS
0	1	Pavement/subgrade.			
1	6.5'	Varicolored, silty to fine sandy CLAY.			
6.5	7.5'	Fine-gr. SANDSTONE.			
7.5'		LIMESTONE.			
		WELL ID: MW-6	Elevation determined by arbitrary benchmark.		
			Casing height/grout variance granted by RDHE.		

7 CONTRACTOR'S OR LANDOWNER'S CERTIFICATION: This water well was **1** constructed, (2) reconstructed, or (3) plugged under my jurisdiction and was completed on (mo/day/year) **4/5/91** and this record is true to the best of my knowledge and belief. Kansas Water Well Contractor's License No. **102** This Water Well Record was completed on (mo/day/yr) **5/9/91** under the business name of **LAYNE-WESTERN CO.** by (signature) **Paul W. Famb**

OFFICE USE ONLY T R E W SEC. 1/4 1/4 1/4 1/4