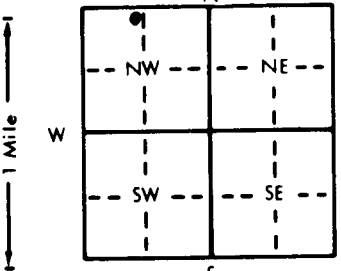


1 LOCATION OF WATER WELL:		Fraction	Section Number	Township Number	Range Number
County: Johnson		NE 1/4 NW 1/4 NW 1/4	12	T 13 S	R 24 EW
Distance and direction from nearest town or city street address of well if located within city? 10075 West 103rd St Overland Park, KS					
2 WATER WELL OWNER: Texaco Refinery Inc. RR#, St. Address, Box #: 1437 S. Boulder City, State, ZIP Code: Tulsa, OK 74119 Board of Agriculture, Division of Water Resources Application Number:					
3 LOCATE WELL'S LOCATION WITH AN "X" IN SECTION BOX:		4 DEPTH OF COMPLETED WELL: 13' ft. ELEVATION:			
		Depth(s) Groundwater Encountered 1. - ft. 2. - ft. 3. - ft. WELL'S STATIC WATER LEVEL Dry ft. below land surface measured on mo/day/yr 5-7-98 Pump test data: Well water was - ft. after - hours pumping - gpm Est. Yield - gpm Well water was - ft. after - hours pumping - gpm Bore Hole Diameter 8 1/2" in. to 8' ft. and 5 1/2" in. to 13' ft. WELL WATER TO BE USED AS: 5 Public water supply 8 Air conditioning 11 Injection well 1 Domestic 3 Feedlot 6 Oil field water supply 9 Dewatering 12 Other (Specify below) 2 Irrigation 4 Industrial 7 Lawn and garden only 10 Monitoring well Was a chemical/bacteriological sample submitted to Department? Yes No X If yes, mo/day/yr sample was submitted Water Well Disinfected? Yes No			
5 TYPE OF BLANK CASING USED: 1 Steel 3 RMP (SR) 5 Wrought iron 8 Concrete tile CASING JOINTS: Glued Clamped 2 PVC 4 ABS 6 Asbestos-Cement 9 Other (specify below) Welded Blank casing diameter 2 3/4 in. to 3' ft. Dia in. to SDR 13 ft. Casing height above land surface Flush ft. in. weight lbs./ft. Wall thickness or gauge No. SDH 40 TYPE OF SCREEN OR PERFORATION MATERIAL: 1 Steel 3 Stainless steel 5 Fiberglass 8 RMP (SR) 10 Asbestos-cement 2 Brass 4 Galvanized steel 6 Concrete tile 9 ABS 11 Other (specify) 12 None used (open hole) SCREEN OR PERFORATION OPENINGS ARE: 1 Continuous slot 3 Mill slot 5 Gauzed wrapped 8 Saw cut 11 None (open hole) 2 Louvered shutter 4 Key punched 6 Wire wrapped 9 Drilled holes 10 Other (specify) SCREEN-PERFORATED INTERVALS: From 13' ft. to 3' ft. From - ft. to - ft. GRAVEL PACK INTERVALS: From 13' ft. to 2' ft. From - ft. to - ft.					
6 GROUT MATERIAL: 1 Neat cement 2 Cement grout 3 Bentonite 4 Other Grout Intervals: From 2' ft. to 1 1/2' ft. From 1 1/2' ft. to 0 ft. What is the nearest source of possible contamination: 1 Septic tank 4 Lateral lines 7 Pit privy 10 Livestock pens 14 Abandoned water well 2 Sewer lines 5 Cess pool 8 Sewage lagoon 11 Fuel storage 15 Oil well/Gas well 3 Watertight sewer lines 6 Seepage pit 9 Feedyard 12 Fertilizer storage 16 Other (specify below) 13 Insecticide storage Direction from well? North How many feet? 60'					
7 CONTRACTOR'S OR LANDOWNER'S CERTIFICATION: This water well was (1) constructed, (2) reconstructed, or (3) plugged under my jurisdiction and was completed on (mo/day/year) 5-6-98 and this record is true to the best of my knowledge and belief. Kansas Water Well Contractor's License No. 539 This Water Well Record was completed on (mo/day/year) 5-11-98 under the business name of JB Environmental Drilling by (signature) James Becker INSTRUCTIONS: Use typewriter or ball point pen. PLEASE PRESS FIRMLY and PRINT clearly. Please fill in blanks, underline or circle the correct answers. Send top three copies to Kansas Department of Health and Environment, Bureau of Water, Topeka, Kansas 66620-0001. Telephone: 913-296-5545. Send one to WATER WELL OWNER and retain one for your records.					