

WATER WELL PLUGGING RECORD Form WWC-5P

KSA 82a-1212

ID NO.

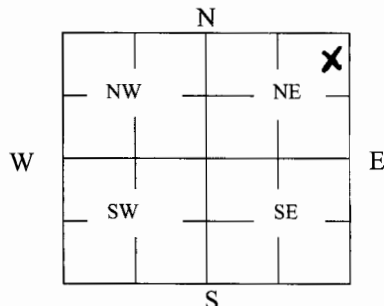
1 LOCATION OF WATER WELL: County: <u>JOHNSON</u>	Fraction <u>NE 1/4 NE 1/4 NE 1/4</u>	Section Number <u>29</u>	Township Number <u>13</u>	Range Number <u>24</u>	E/W
---	---	-----------------------------	------------------------------	---------------------------	-----

Distance and direction from nearest town or city street address of well if located within city?

8 W OF INTERSECTION OF 127TH & BLACK BOB

2 WATER WELL OWNER: <u>ICS BLACK BOB LLC</u> RR#, St. Address, Box #: <u>C/O GREIDTANEY</u> <u>1 WARD PKWY SUITE 305</u> City, State ZIP Code: <u>K.C., MISSOURI 64112</u>	Global Positioning System (decimal degrees, min. of 4 digits) Latitude: <u>94° 45' 41.33" W</u> Longitude: <u>38° 53' 49.18" N</u> Elevation: <u>978.00</u> Datum: Data Collection Method: <u>GPS</u>
---	--

3 MARK WELL'S LOCATION WITH AN "X" IN SECTION BOX:

4 DEPTH OF WELL 26 ft.WELL'S STATIC WATER LEVEL 11 ft

WELL WAS USED AS:

- | | | |
|--------------|----------------------------|---------------------------|
| 1 Domestic | 5 Public Water Supply | 9 Dewatering |
| 2 Irrigation | 6 Oil Field Water Supply | 10 Monitoring |
| 3 Feedlot | 7 Domestic (Lawn & Garden) | 11 Injection Well |
| 4 Industrial | 8 Air Conditioning | 12 Other <u>ABANDONED</u> |

Was a chemical/bacteriological sample submitted to Department? Yes _____ No X

5 TYPE OF BLANK CASING USED:

- | | | | | |
|---------|------------|-------------------|-----------------|-------------------------|
| 1 Steel | 3 RMP (SR) | 5 Wrought | 7 Fiberglass | 9 Other (Specify below) |
| 2 PVC | 4 ABS | 6 Asbestos-Cement | 8 Concrete Tile | <u>ROCK</u> |

Blank casing diameter 60 in. Was casing pulled? Yes _____ No X If yes, how much _____

Casing height above or below land surface _____ in.

6 GROUT PLUG MATERIAL: 1 Neat cement 2 Cement grout 3 Bentonite 4 Other SANDGrout Plug Intervals: From 10 ft. to 7 ft., From _____ ft. to _____ ft., From _____ to _____ ft.

What is the nearest source of possible contamination:

- | | | | |
|--------------------------|-------------------|-------------------------|----------------------------|
| 1 Septic tank | 6 Seepage pit | 11 Fuel Storage | 16 Other (specify below) |
| 2 Sewer lines | 7 Pit privy | 12 Fertilizer storage | |
| 3 Watertight sewer lines | 8 Sewage lagoon | 13 Insecticide storage | |
| 4 Lateral lines | 9 Feedyard | 14 Abandoned water well | Direction from well? _____ |
| 5 Cess pool | 10 Livestock pens | 15 Oil well/Gas well | How many feet? _____ |

FROM	TO	PLUGGING MATERIALS	FROM	TO	PLUGGING MATERIALS
<u>26'</u>	<u>10'</u>	<u>SAND</u>	<u>10'</u>	<u>7'</u>	<u>CEMENT</u>
<u>7'</u>	<u>GROUND</u>	<u>COMPACTED CLAY</u>			

7 CONTRACTOR'S OR LANDOWNER'S CERTIFICATION: This water well was plugged under my jurisdiction and was completed on (mo/day/year) 10/24/06 and this record is true to the best of my knowledge and belief. Kansas Water Well Contractor's License No. _____. This Water Well Record was completed on (mo/day/year) 11/6/06 under the business name of MID STATES EXCAVATING by (signature) Walter O. Doherty

INSTRUCTIONS: Use typewriter or ballpoint pen. Please press firmly and print clearly. Please fill in blanks, underline or circle the correct answers. Send top three copies to Kansas Department of Health and Environment, Bureau of Water, Geology Section, 1000 SW Jackson St., Ste. 420, Topeka, Kansas 66612-1367. Telephone: 785/296-5522. Send one to Water Well Owner and retain one for your records. Visit us at <http://www.kdheks.gov/geo/waterwells>.