

Lmw-1

KSA 82a-1212

Drafter: APP/ELS

Date: 08/29/07

Contract Number: 19-15984A

Approved:

Revised:

ENVIRON


SAMPLE LOCATION MAP
EAGLE PICHER PHARMACEUTICAL SERVICES, LLC
13605 W. 96TH TERRACE
LENEXA, KANSAS

2

Figure

APPROX. SCALE (ft.)
0 80

	SOIL SAMPLE LOCATION		NO STORM WATER INLET SEDIMENT WAS ACCESSIBLE TO COLLECT FOR SAMPLE ANALYSIS
	SOIL SAMPLE LOCATION - DUPLICATE		ANIMAL STORM WATER INLET SEDIMENT AVAILABLE TO SAMPLE
	MONITORING WELL LOCATION		GROUND WATER FLOW DIRECTION
	SUFFICIENT STORM WATER INLET SEDIMENT WAS AVAILABLE TO COLLECT FOR THE FULL SUITE OF ANALYSIS		

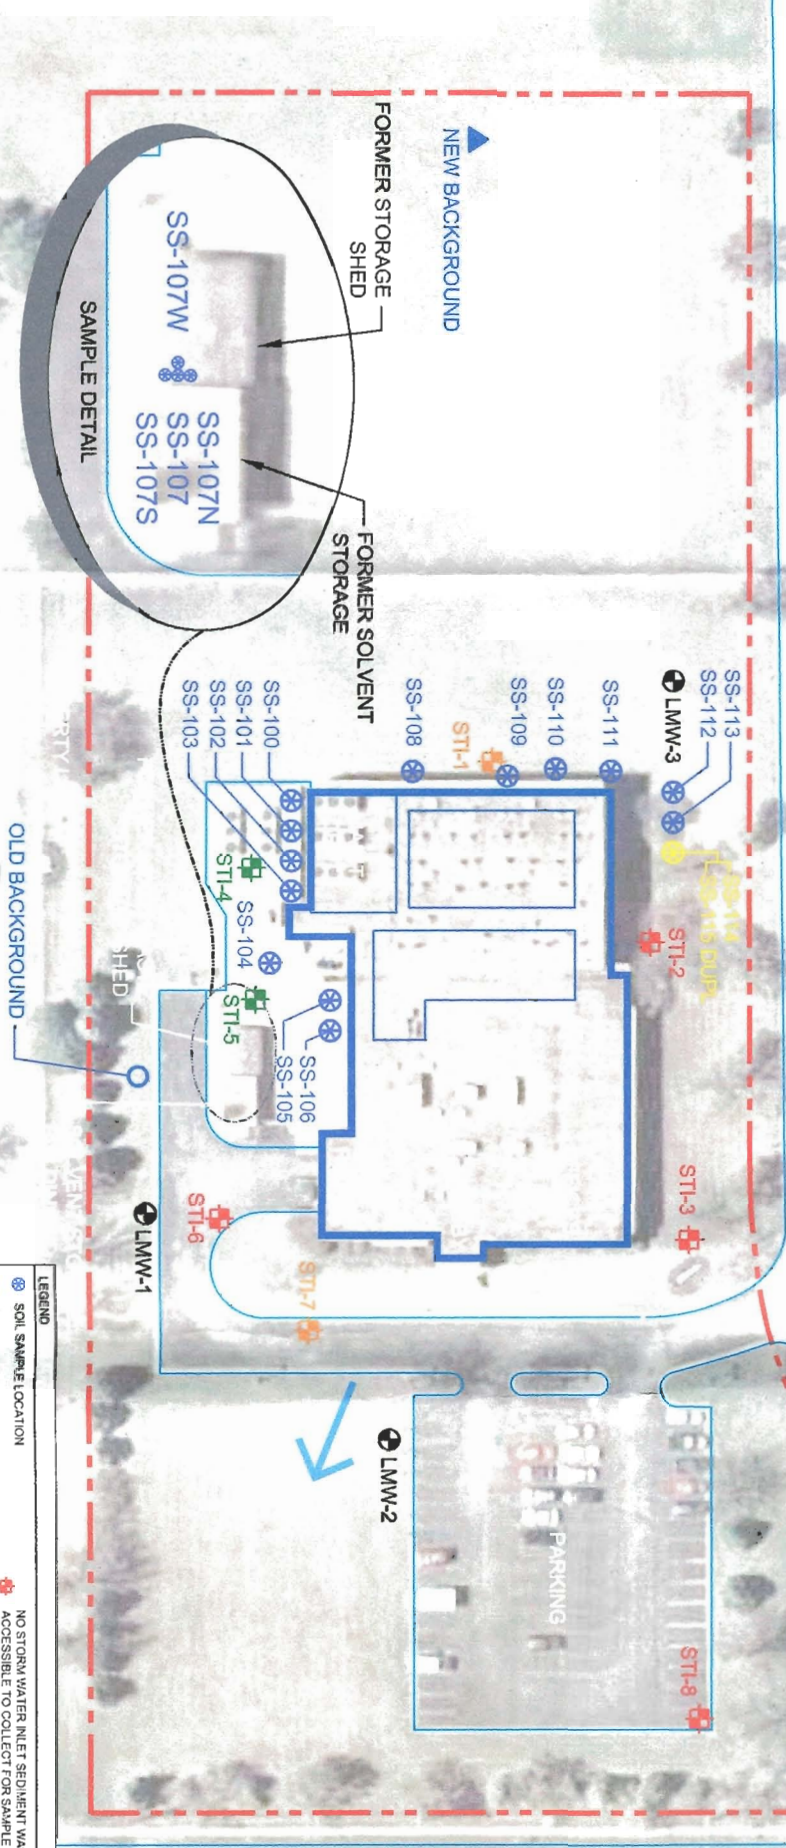

RECEIVED
DEC 13 2010

BUREAU OF WATER