

CORRECTION(S) TO WATER WELL RECORD (WWC-5)

(to rectify lacking or incorrect information)

County: Johnson

Location listed as:

Section-Township-Range: 31-135-24E

Fraction ($\frac{1}{4}$ $\frac{1}{4}$ $\frac{1}{4}$): unclear

Location changed to:

31-135-24E

SW NW NW NE

Other changes: Initial statements: _____

Changed to: _____

Comments: _____

verification method: Latitude & longitude, KGS' "LEO" conversion tool,
information on attachments to WWC5 form, and mapping tool &
aerial photos on KGS website. initials: DRL date: 5/9/2011

submitted by: Kansas Geological Survey, Data Resources Library, 1930 Constant Ave., Lawrence, KS 66047-3726
to: Kansas Dept of Health & Environment, Bureau of Water, 1000 SW Jackson, Suite 420, Topeka, KS 66612-1367.

mw-5

KSA 82a-1212



Property Solutions INC.
Environmental & Engineering Consulting
Property Solutions Inc.
Phone: 856-813-3000 Fax: 856-812-1068

FIELD BOREHOLE LOG

BORING NO.: **SB-11/MW-05**

TOTAL DEPTH: **8 ft**

PROJECT INFORMATION

DRILLING INFORMATION

PROJECT NO.: 20102644
CLIENT: Townsquare Investors L.P.
PROJECT NAME: Townsquare Shopping Center
SITE LOCATION: 102-104 South Clairborne Road, Olathe, Kansas
BORING LOCATION: Former Dry Cleaner Tenant Space

DATE STARTED: 08/13/10 **COMPLETED:** 08/13/10

DRILLING CO.: PSA Envirometnal
DRILLER: Bill Wilson
RIG TYPE: Geoprobe®
DRILLING METHOD: Direct Push/Hollow Stem Auger
SAMPLING METHODS: Macrocore
FIELD PERSONNEL: Ralph Capone
HAMMER WT./DROP:

☞ Water level during drilling

☞ Water level in completed well

DEPTH	SOIL SYMBOLS	USCS	SOIL DESCRIPTION	SAMPLE No.	PID ppm	WELL CONSTRUCTION	WELL DESCRIPTION
0	[Pattern]	ML	Mottled orange-brown silt, little to some clay, stiff		0.0		
5					0.0		
				SB-(7.5-8.0)-11			

RECEIVED

JAN 13 2011


BUREAU OF WATER

NOTES: Refusal at 8 ft.

BUREAU OF WATER

JAN 13 2011

RECEIVED

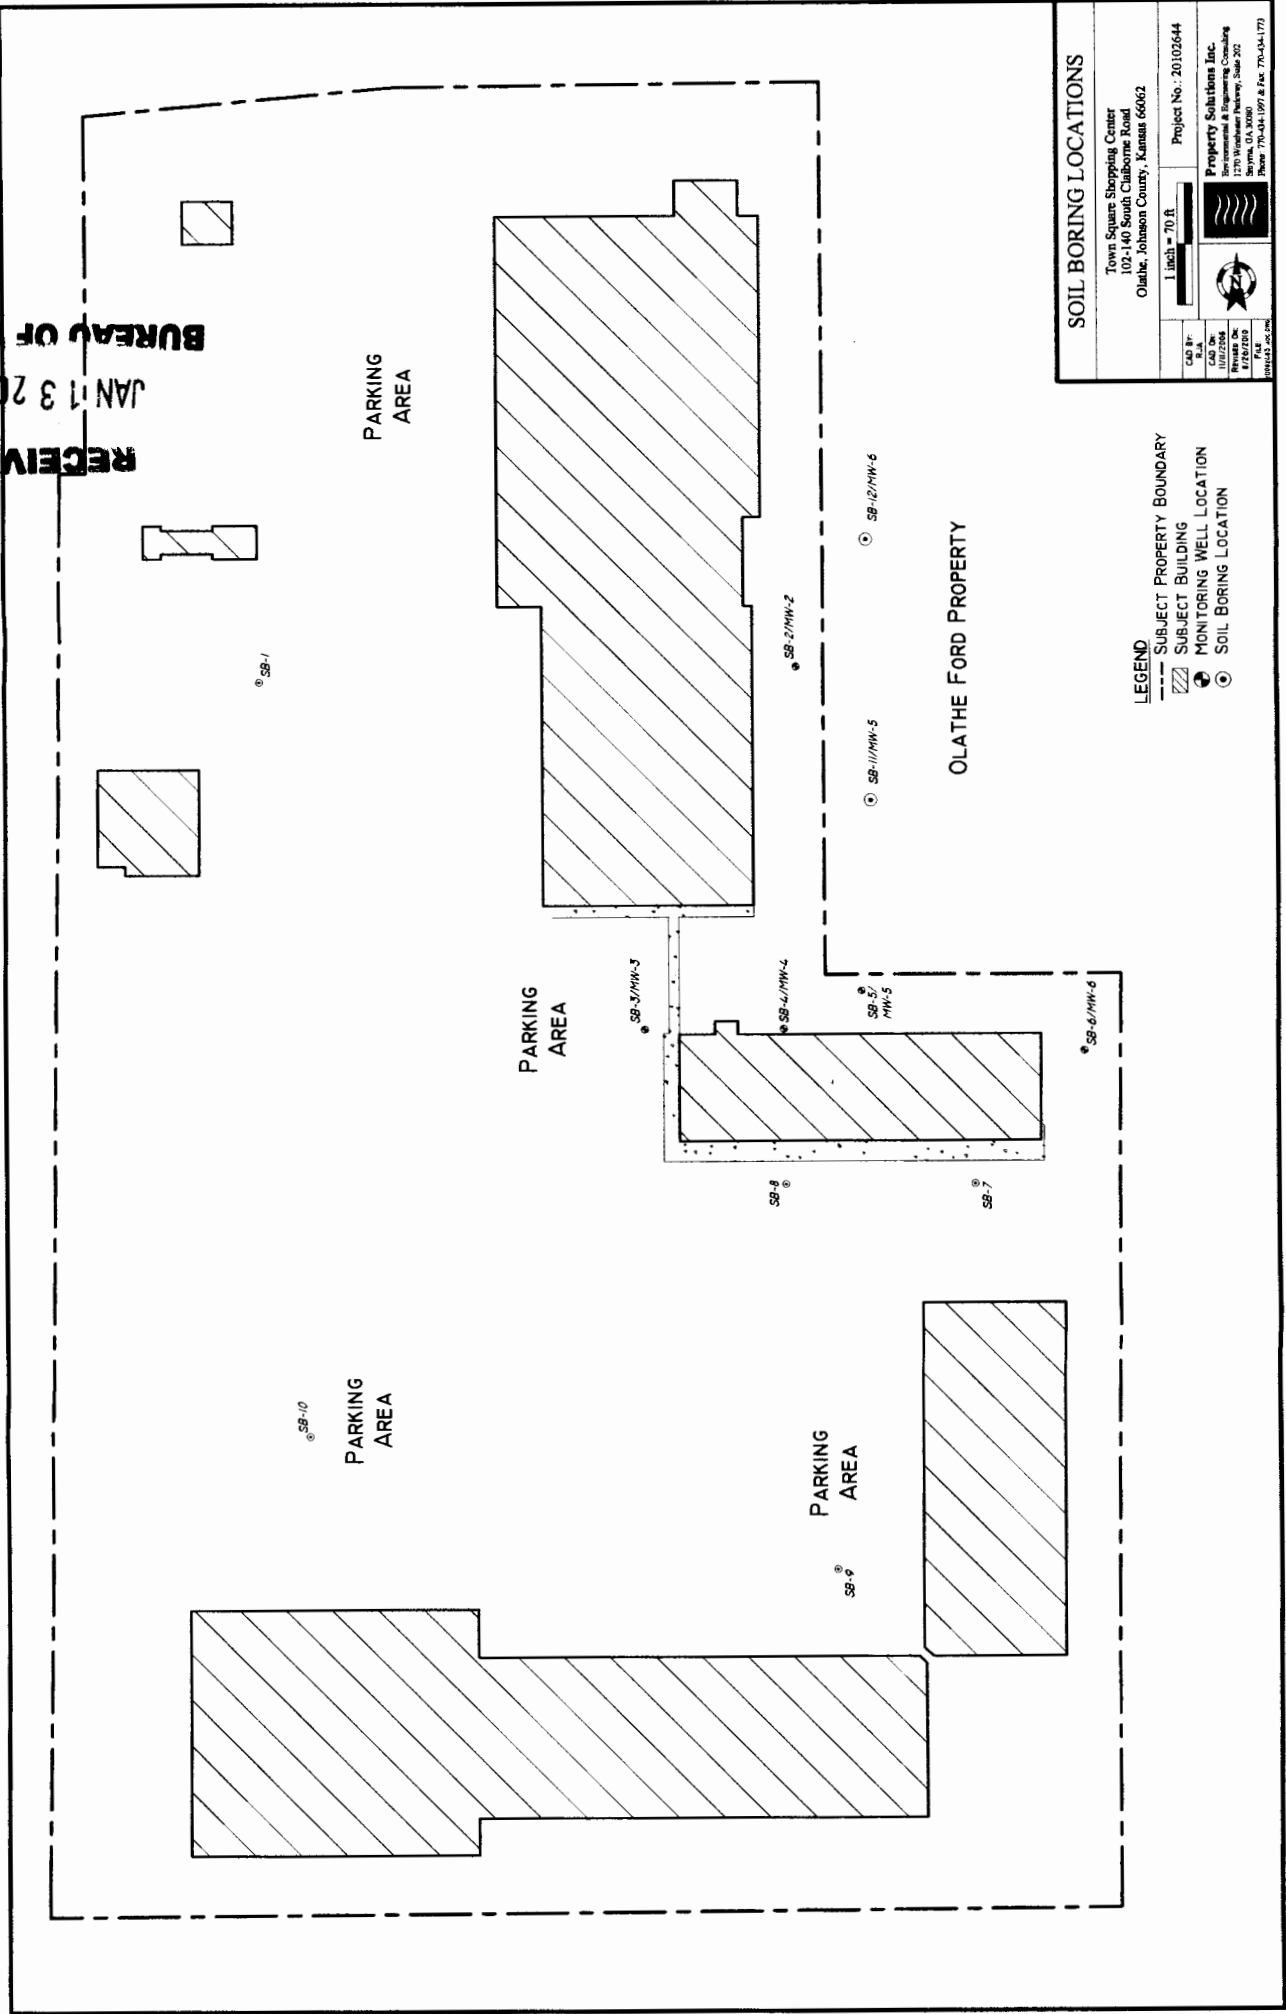

SOIL BORING LOCATIONS

Town Square Shopping Center
Olathe, Johnson County, Kansas 66062

Project No. 20102644

Property Solutions Inc.

Scale: 1 inch = 70 ft

DATE BY: R.A.
REVISED ON: 1/10/2009
REVISED BY: R.A.

LEGEND

- SUBJECT PROPERTY BOUNDARY
- /// SUBJECT BUILDING
- MONITORING WELL LOCATION
- ⊗ SOIL BORING LOCATION