

CORRECTION(S) TO WATER WELL RECORD (WWC-5)

(to rectify lacking or incorrect information)

County: Johnson

Location listed as:

Section-Township-Range: 31-135-24E

Fraction ($\frac{1}{4}$ $\frac{1}{4}$ $\frac{1}{4}$): unclear

Location changed to:

31-135-24E

SE NW NW NE

Other changes: Initial statements: _____

Changed to: _____

Comments: _____

verification method: Latitude & longitude, KGS' "LEO" conversion tool,
information on attachments to WWC5 form, and mapping tool
& aerial photos on KGS website. initials: ORL date: 5/9/2011

submitted by: Kansas Geological Survey, Data Resources Library, 1930 Constant Ave., Lawrence, KS 66047-3726

to: Kansas Dept of Health & Environment, Bureau of Water, 1000 SW Jackson, Suite 420, Topeka, KS 66612-1367.

mw-6

KSA 82a-1212



Property Solutions INC.

Environmental & Engineering Consulting
Property Solutions Inc.

Phone: 856-813-3000 Fax: 856-812-1068

FIELD BOREHOLE LOG

BORING NO.: **SB-12/MW-06**

TOTAL DEPTH: **9 ft**

PROJECT INFORMATION

PROJECT NO.: 20102644

CLIENT: Townsquare Investors L.P.

PROJECT NAME: Townsquare Shopping Center

SITE LOCATION: 102-104 South Clairborne Road, Olathe, Kansas

BORING LOCATION: Former Dry Cleaner Tenant Space

DATE STARTED: 08/13/10

COMPLETED: 08/13/10

DRILLING INFORMATION

DRILLING CO.: PSA Envirometnal

DRILLER: Bill Wilson

RIG TYPE: Geoprobe®

DRILLING METHOD: Direct Push/Hollow Stem Auger

SAMPLING METHODS: Macrocore

FIELD PERSONNEL: Ralph Capone

HAMMER WT./DROP:

☒ Water level during drilling

☒ Water level in completed well

DEPTH	SOIL SYMBOLS	USCS	SOIL DESCRIPTION	SAMPLE No.	PID ppm	WELL CONSTRUCTION	WELL DESCRIPTION
0		ML	Mottled orange-brown silt, little to some clay, stiff		0.0		
5					0.0		
			Tanish-brown limestone	SB-(7.5-8.0)-12	0.0		

RECEIVED

JAN 19 2011

BUREAU OF WATER


NOTES: Refusal at 9 ft.

Page 1 of 1

BUREAU OF WATER

JAN 13 2011

RECEIVED

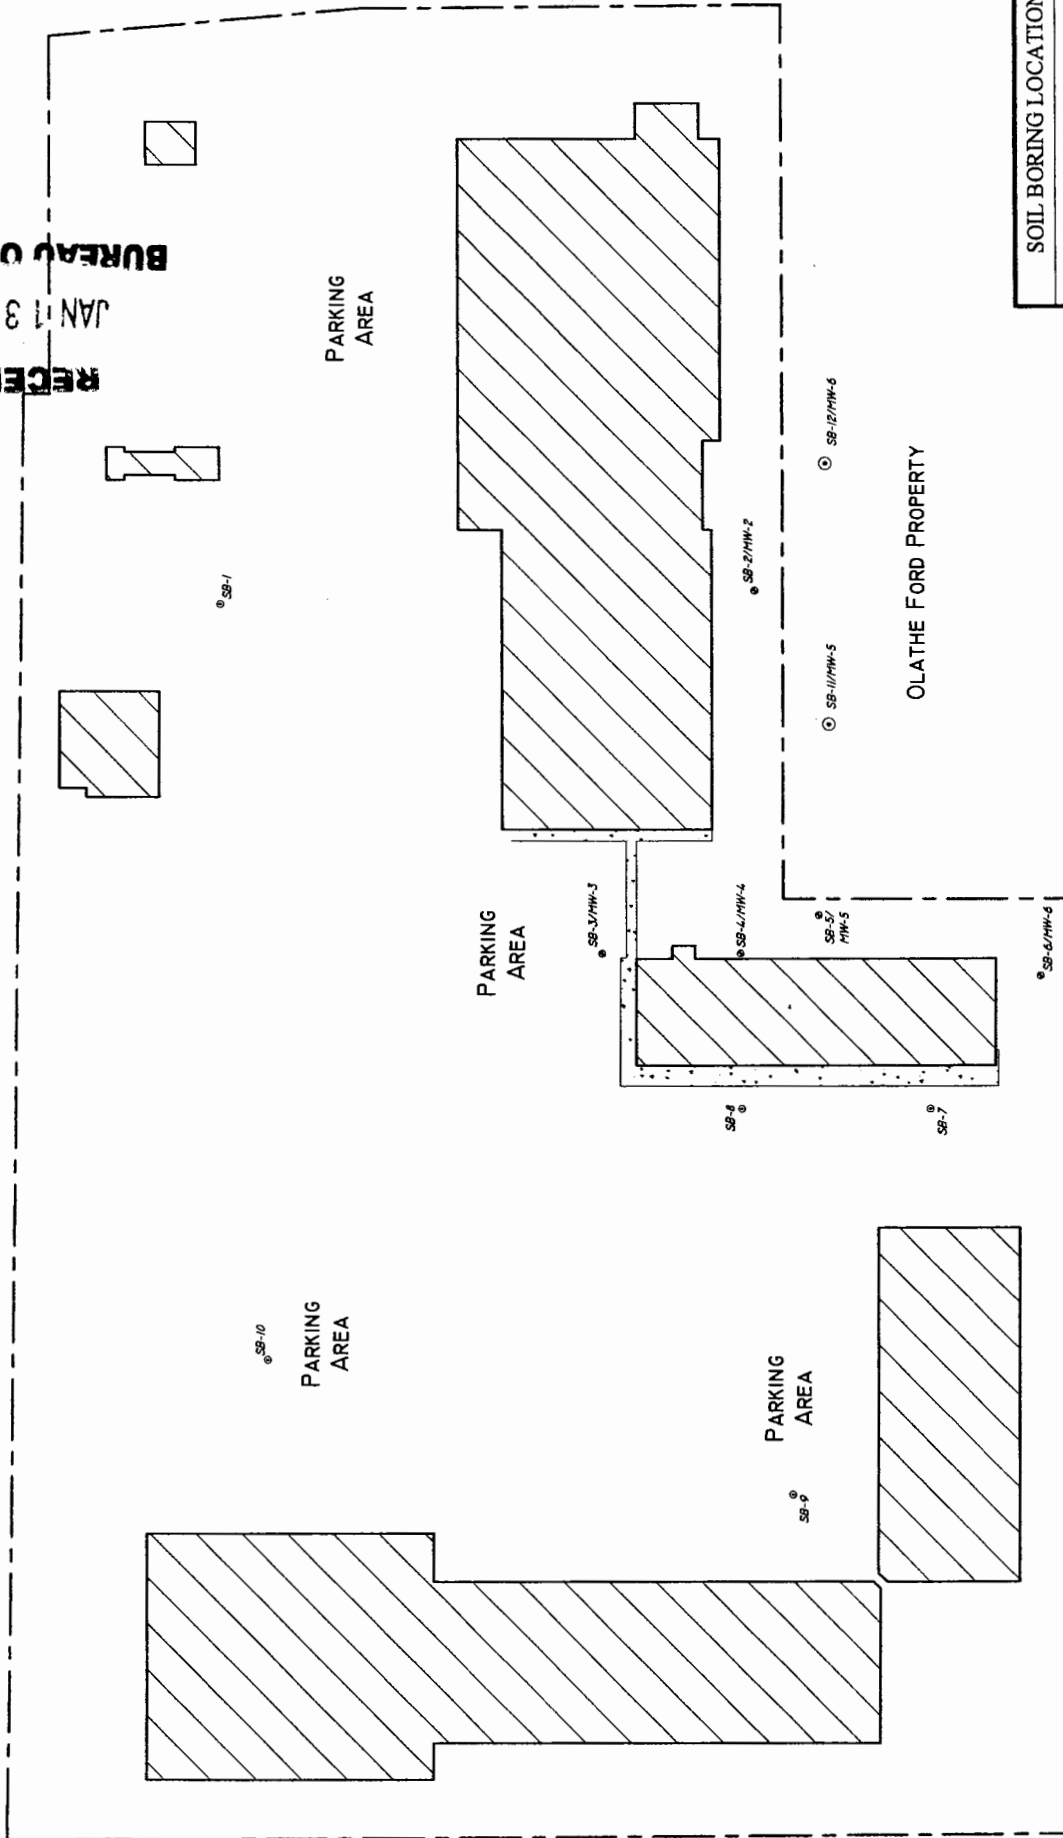

SOIL BORING LOCATIONS

Town Square Shopping Center
102-140 South Clubborne Road
Olathe, Johnson County, Kansas 66062

Project No.: 20102644

Property Solutions Inc.
Environmental & Engineering Consulting
1270 Westwood Parkway, Suite 202
Bryan, TX 77801-3997 & P.O. Box 770-04-17D



1 inch = 70 ft

- LEGEND
- SUBJECT PROPERTY BOUNDARY
 - ▨ SUBJECT BUILDING
 - ⊙ MONITORING WELL LOCATION
 - SOIL BORING LOCATION