

☐ Original Record ☒ Correction ☐ Change in Well Use

Well ID


MW 13

[illegible]

Johnson SW SW SE 30-13S-24E


RECEIVED
 SEP 14 2018
 BUREAU OF WATER

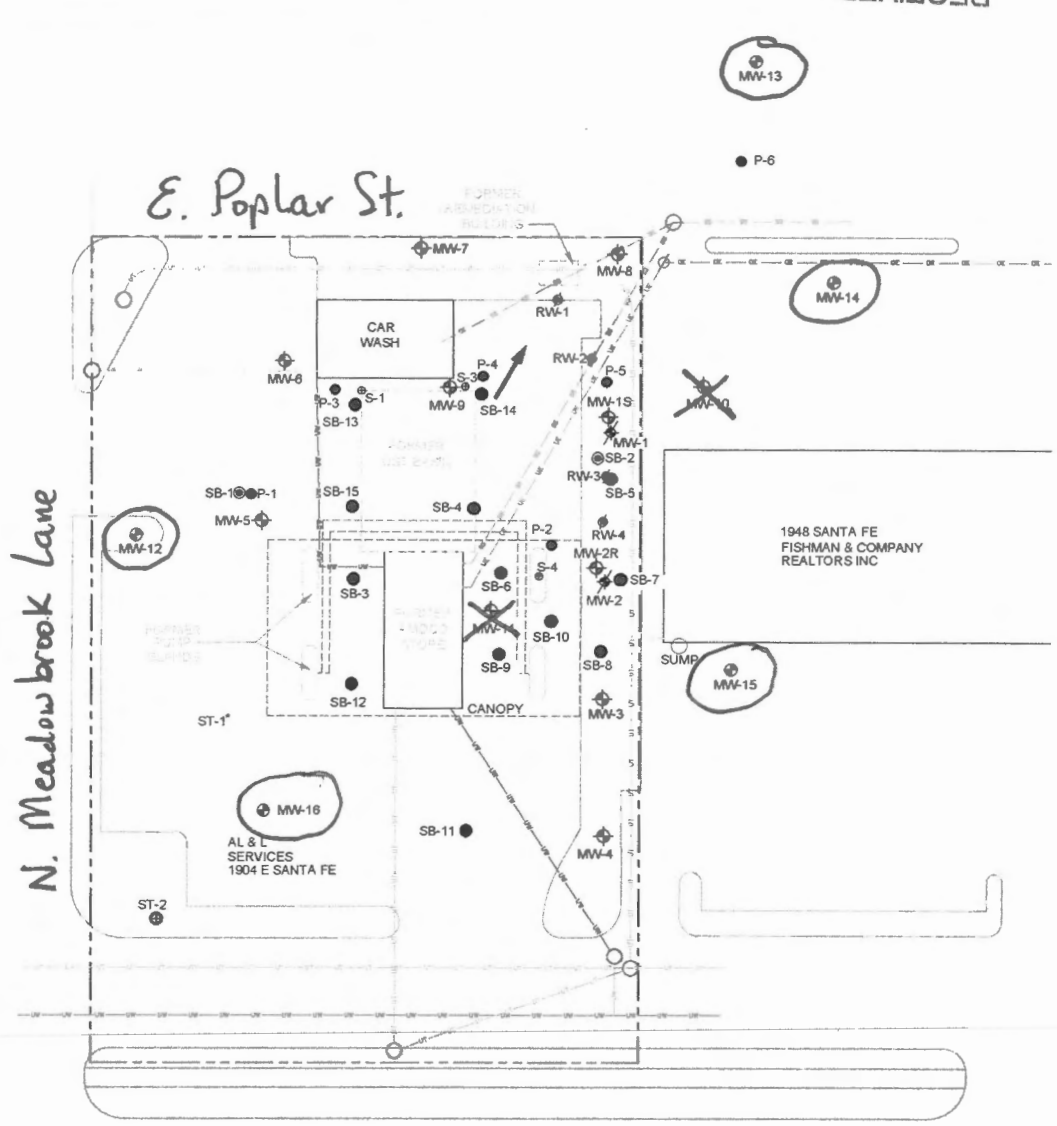

- LEGEND**
- MW-3 GROUNDWATER MONITORING WELL
 - MW-1 DESTROYED MONITORING WELL
 - RW-1 FORMER RECOVERY WELL LOCATION
 - P-1 DIRECT PUSH POINTS
ADVANCED BY HYDROLOGIC, INC.
 - SB-1 SOIL BORING LOCATION
 - ST-1 GEOTECHNICAL SAMPLE LOCATION
 - S-1 SAMPLE COLLECTED BY KDHE
DURING UST REMOVAL
 - PROPOSED SOIL BORING
 - PROPOSED MONITORING WELL
 - PROPOSED GEOTECHNICAL SAMPLE
 - PROPERTY LINE
 - PRODUCT PIPING
 - OVERHEAD ELECTRICAL LINE
 - UNDERGROUND ELECTRICAL LINE
 - UNDERGROUND TELEPHONE LINE
 - UNDERGROUND WATER LINE
 - UNDERGROUND SANITARY SEWER
 - UNDERGROUND GAS LINE
 - UTILITY POLE
 - MANHOLE
 - GROUNDWATER FLOW DIRECTION

0 30' 60'
 APPROXIMATE SCALE 1 in. = 30 ft.

FORMER AMOCO #2131
 KDHE #U4-046-00116
 1904 EAST SANTA FE
 OLATHE, KANSAS

SITE MAP

ARCADIS Design & Construction
 Environmental & Engineering

FIGURE
2