

County: Johnson Fraction SW NW NE NW Sec. 16 T 13 S R 24 EW

CORRECTION(S) TO WATER WELL COMPLETION RECORD (WWC-5)

(to rectify lacking or incorrect information)

Owner: Merit

Location was listed as:

Section-Township-Range: None Given

Fraction ($\frac{1}{4}$ $\frac{1}{4}$ $\frac{1}{4}$): _____

Location changed to:

16-13 S-24 E

SW NW NE NW

Other changes: Initial statements: _____

Changed to: _____

Comments: _____

Verification method: Latitude & Longitude, KGS' "LEO" conversion tool,
written description, and mapping tool on KGS website.

initials: DRL date: 6/24/2013

Submitted by: Kansas Geological Survey, Data Resources Library, 1930 Constant Ave., Lawrence, KS 66047-3726

to: Kansas Dept of Health & Environment, Bureau of Water, 1000 SW Jackson, Suite 420, Topeka, KS 66612-1367.

WATER WELL PLUGGING RECORD Form WWC-5P
KSA 82a-1212
ID NO.

1 LOCATION OF WATER WELL: County: Johnson	Fraction 1/41/41/41/4	Section Number	Township Number T S	Range Number ☐ E☐ W
---	---	----------------	------------------------	---

Street/Rural Address of Well Location; if unknown, distance & direction from nearest town or intersection: If at owner's address, check here ☒ 112th Street & Strang Line Road, Olathe

750' from coner of 112th & 600' from Stang Line Road

Global Positioning Systems (GPS) information:

Latitude: N 38 55' 34.3" (in decimal degrees)

Longitude: W 094 45' 19.0" (in decimal degrees)

Elevation:

Datum: ☐ WGS84, ☐ NAD83, ☐ NAD27

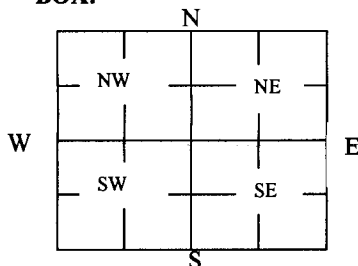
Collection Method:

☒ GPS unit (Make/Model: Garmin E-Trex 10

☐ Digital Map/Photo, ☐ Topographic Map, ☐ Land Survey

Est. Accuracy: ☐ < 3 m, ☐ 3-5 m, ☐ 5-15 m, ☐ > 15 m

2 WATER WELL OWNER: Merit
RR#, St. Address, Box #: 16400 W 118th Street
City, State ZIP Code: Olathe KS 66061

3 MARK WELL'S LOCATION WITH AN "X" IN SECTION BOX:

4 DEPTH OF WELL 9 **ft.**

WELL'S STATIC WATER LEVEL 8 **ft**

WELL WAS USED AS:

☒ Domestic
☐ Irrigation
☐ Feedlot
☐ Industrial

☐ Public Water Supply
☐ Oil Field Water Supply
☐ Domestic (Lawn & Garden)
☐ Air Conditioning

☐ Dewatering
☐ Monitoring
☐ Injection Well
☐ Other

Was a chemical/bacteriological sample submitted to Department? Yes ☐ No ☐

5 TYPE OF BLANK CASING USED:

☐ Steel
☐ PVC

☐ RMP (SR)
☐ ABS

☐ Wrought
☐ Asbestos-Cement

☐ Fiberglass
☒ Concrete Tile

☐ Other (Specify below)

Blank casing diameter 36" in. Was casing pulled? Yes ☒ No ☐ If yes, how much _____
Casing height above or below land surface 36" in.

6 GROUT PLUG MATERIAL: ☒ Neat cement ☐ Cement grout ☐ Bentonite ☐ Other

Grout Plug Intervals: From 8 ft. to 0 ft., From _____ ft. to _____ ft., From _____ to _____ ft.

What is the nearest source of possible contamination:

☐ Septic tank
☐ Sewer lines
☐ Watertight sewer lines
☐ Lateral lines
☐ Cess pool

☐ Seepage pit
☐ Pit privy
☐ Sewage lagoon
☐ Feedyard
☐ Livestock pens

☒ Fuel Storage
☐ Fertilizer storage
☐ Insecticide storage
☐ Abandoned water well
☐ Oil well/Gas well

☐ Other (specify below)
Phillips 66 gas station

Direction from well? West
How many feet? 1000' to 1500'

FROM	TO	PLUGGING MATERIALS	FROM	TO	PLUGGING MATERIALS
9'	8'	sand			
8'	0'	neat cement			

7 CONTRACTOR'S OR LANDOWNER'S CERTIFICATION: This water well was plugged under my jurisdiction and was completed on (mo/day/year) 05/01/13 and this record is true to the best of my knowledge and belief. Kansas Water Well Contractor's License No. 617. This Water Well Record was completed on (mo/day/year) 05/02/13 under the business name of Douglas Pump Service Inc by (signature) Billy Perry

INSTRUCTIONS: Use typewriter or ballpoint pen. Please press firmly and print clearly. Please fill in blanks, underline or circle the correct answers. Send top three copies to Kansas Department of Health and Environment, Bureau of Water, Geology Section, 1000 SW Jackson St., Ste. 420, Topeka, Kansas 66612-1367. Telephone: 785/296-5524. Send one to Water Well Owner and retain one for your records. Visit us at <http://www.kdheks.gov/waterwell/index.html>.

Check one: ☒ White Copy ☐ Blue Copy ☐ Pink Copy